

15-175-00126-0000

STATE OF KANSAS  
STATE CORPORATION COMMISSION

WELL PLUGGING RECORD

Give All Information Completely  
Make Required Affidavit  
Mail or Deliver Report to:  
Conservation Division  
State Corporation Commission  
800 Bittling Building  
Wichita, Kansas

Seward County. Sec. 2 Twp. 33 Rge. 33W. (E) (W)

Location as "NE/CNW $\frac{1}{4}$ SW $\frac{1}{4}$ " or footage from lines 100'S & 100'W of Cen.

Lease Owner American Gas Production Company

Lease Name Browne "A" Well No. 1

Office Address Bartlesville, Oklahoma

Character of Well (completed as Oil, Gas or Dry Hole) Gas-Unable to shut off water

Date well completed 19

Application for plugging filed Jan. 5-1951 19

Application for plugging approved Jan. 8-1951 19


Plugging commenced Jan 8-1951 19

Plugging completed Jan. 9, 1951 19

Reason for abandonment of well or producing formation Unable to shut off water

If a producing well is abandoned, date of last production No Production 19

Was permission obtained from the Conservation Division or its agents before plugging was commenced? Yes

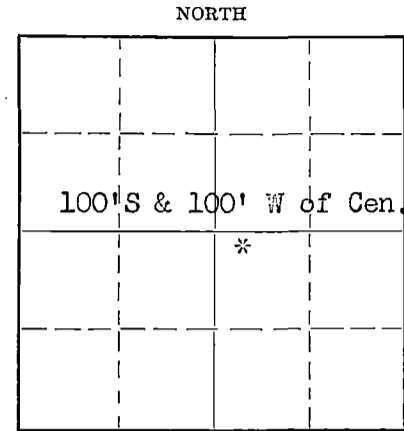

Locate well correctly on above Section Plat

Name of Conservation Agent who supervised plugging of this well R. J. Phillipe

Producing formation Herrington & U-Krider Depth to top 2564 Bottom 2610 Total Depth of Well 2735 Feet

Show depth and thickness of all water, oil and gas formations.

OIL, GAS OR WATER RECORDS

CASING RECORD

Formation	Content	From	To	Size	Put In	Pulled Out
				8-5/8"	600	None
				5 1/2"	2739	None

Describe in detail the manner in which the well was plugged, indicating where the mud fluid was placed and the method or methods used in introducing it into the hole. If cement or other plugs were used, state the character of same and depth placed, from feet to feet for each plug set.

Lower Krider 2626 to 2652/ 130-shots; Acidize got salt water; show gas; squeeze off  
 Upper Krider 2596-2610 70-shots Acidize got salt water  
 Herrington 2564-2576 60-shots " " " P&A

57'-3/4" rock from 2558/40/2/1 2615 to 2558; dumped 18' cement with dump bailer from 2540 to 2558'.

Mud to 35', 30' cement plug from 5' to 35'; cut off casing 5' below ground level, weld steel cap on casing.

(If additional description is necessary, use BACK of this sheet)

Correspondence regarding this well should be addressed to H. V. Anderson  
Address Box 70 Liberal, Kansas

STATE OF Kansas COUNTY OF Seward, ss.

(employee of owner) or (owner or operator) of the above-described well, being first duly sworn on oath, says: That I have knowledge of the facts, statements, and matters herein contained and the log of the above-described well as filed and that the same are true and correct. So help me God.

(Signature) H. V. Anderson

Box 70 Liberal, Kansas (Address)

SUBSCRIBED AND SWORN to before me this 13th day of January, 19 51

My commission expires 5-23-1953

22-7377-s 4-49-10M

PLUGGING  
FILE SEC 2 133 R 332  
BOOK PAGE 52 LINE 28

Notary Public  
J. G. Makray  
STATE OF KANSAS  
COMMISSIONER  
JAN 15 1951  
CONSERVATION DIVISION  
Wichita, Kansas