

WELL PLUGGING RECORD

Give All Information Completely
Make Required Affidavit
Mail or Deliver Report to:
Conservation Division
State Corporation Commission
211 No. Broadway
Wichita, Kansas

SEWARD County. Sec. 4 Twp. 33S Rge. 33 (E) W (W)

Location as "NE/CNW/SW" or footage from lines NW/4 1250' FROM N LINE; 1250' FROM W LINE

Lease Owner MALLONEE-MAHONEY, INC. Well No. 1

Lease Name COSGROVE "A" Office Address 925 SUTTON PLACE, WICHITA, KANSAS 67901

Character of Well (completed as Oil, Gas or Dry Hole) GAS WELL

Date well completed 6/28 1972

Application for plugging filed 1/28 1974

Application for plugging approved 1/29 1974


Plugging commenced 2/3 1974

Plugging completed 2/5 1974

Reason for abandonment of well or producing formation NON PRODUCTIVE

If a producing well is abandoned, date of last production 6/17 1973

Was permission obtained from the Conservation Division or its agents before plugging was commenced? YES

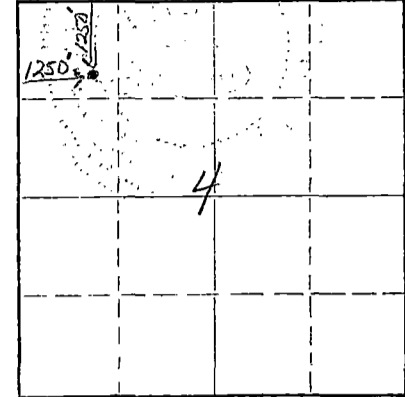

Locate well correctly on above Section Plat

Name of Conservation Agent who supervised plugging of this well ED EYES

Producing formation MORROW Depth to top 5597' Bottom 5606' Total Depth of Well 5800' Feet

Show depth and thickness of all water, oil and gas formations.

OIL, GAS OR WATER RECORDS

CASING RECORD

FORMATION	CONTENT	FROM	TO	SIZE	PUT IN	PULLED OUT

Describe in detail the manner in which the well was plugged, indicating where the mud fluid was placed and the method or methods used in introducing it into the hole. If cement or other plugs were used, state the character of same and depth placed, from _____ feet to _____ feet for each plug set.

5606 TO 5597 20 SX CEMENT

900 TO 800 35 SX CEMENT

45 TO -0- 15 SX CEMENT

RECEIVED
STATE CORPORATION COMMISSION
FEB 7 1974
CONSERVATION DIVISION
Wichita, Kansas

(If additional description is necessary, use BACK of this sheet)
Name of Plugging Contractor SARGENTS CASING PULLING SERVICE
Address LIBERAL, KANSAS 67901

STATE OF KANSAS, COUNTY OF SEWARD, ss.
B. A. CLIFFT (Employee of owner) or (owner or operator) of the above-described

well being first duly sworn on oath, says: That I have knowledge of the facts, statements, and matters herein contained and the log of the above described well as filed and that the same are true and correct. So help me God.

(Signature) *B. A. Clifft*

Box 1257, LIBERAL, KANSAS 67901 (Address)

Subscribed and sworn to before me this 6TH day of FEBRUARY, 1974

Patricia A. Pennington
PATRICIA A. PENNINGTON Notary Public.

My commission expires 12/14/75





DEPARTMENT OF MINES AND MINERALS
OIL AND GAS DIVISION

STATE OF KANSAS

XXXXXXXXXX
XXXXXXXXXX

Permit No. Oil or Gas Well.....
(Kind)

Company MALLONEE-MAHONEY, INC.
 Address 925 Sutton Place, Wichita, Kansas 67202 Casing and Used in Left In Tubing
 Farm COSGROVE Acres..... Size..... Kind of Packer.....
 Location (waters) Section 4-33S-33W 16.....
 Well No. 1-A Elev..... 13.....
 District..... County Seward 10..... Size of.....
 Drilling Commenced June 5, 1972 8 3/4 8-5/8" @ 1422' w/650 Sks 6%..... Depth Set.....
 Drilling Completed June 18, 1972 5 3/16..... Perf. top.....
 Name of Contractor LOHMANN-JOHNSON DRILLING CO., INC. Perf. bottom.....
 Address of Contractor 1302 OLD NATIONAL BANK BLDG., EVANSVILLE, INDIANA 47708 Perf. top.....
 Date Shot..... From..... To..... Perf. bottom.....
 With

Open flow /10ths Water in..... Inch Casing Cemented..... Size..... No. Ft..... Date.....
 /10ths Merc. in..... Inch 4-1/2" @ 5800'

Formation	Color	Hard or Soft	Top	Bottom	Oil, Gas & Coal or Water	Depth Found	Remarks
SURFACE			0	540			
SURFACE SAND & RED BED							
W/ STREAK GYP			540	1100			
SHALE & GYP			1100	1423			
SHALE & SHELL			1423	1650			
SHALE			1650	2335			
LIME & SHALE			2335	2860			
LIME			2860	3265			
LIME & SHALE			3265	3460			
LIME			3460	3735			
LIME & SHALE			3735	3960			
SHALE & LIME			3960	4090			
LIME & SHALE			4090	4350			
LIME			4350	4480			
LIME & SHALE			4480	4763			
LIME			4763	4805			
LIME & SHALE			4805	5125			
LIME			5125	5347			
SHALE & LIME			5347	5619			
LIME & SHALE			5619	5696			
SHALE & LIME			5696	5765			
LIME			5765	5800			
TOTAL DEPTH			5800				

RECEIVED
STATE CORPORATION COMMISSION
FEB 7 1974
CONSERVATION DIVISION
Wichita, Kansas

We, LOHMANN-JOHNSON DRILLING CO., INC., hereby certify that the above is a true and correct Log of the formations encountered in drilling this Well in accordance with the Daily Drilling Reports.

LOHMANN-JOHNSON DRILLING CO., INC.

By Curtis A. Scheible
Curtis A. Scheible, Vice-President

Subscribed and sworn to before me this 28th day of June, 1972

Helen V. Fields
Notary Public

My Commission expires: November 5, 1973

INDI