

15-175-20148-00


STATE OF KANSAS
STATE CORPORATION COMMISSION

Form CP-4

WELL PLUGGING RECORD

Give All Information Completely
Make Required Affidavit
Mail or Deliver Report to:
Conservation Division
State Corporation Commission
212 No. Market
Wichita, Kansas 67202

NORTH

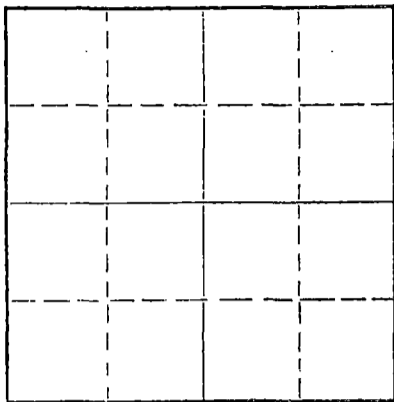

Locate well correctly on above
Section Flat

Seward

County. Sec. 6 Twp. 33S Rge. (E) 33 (W)

Location as "NE/CNW/SW" or footage from lines C NE NE
Lee Banks

Lease Owner _____
Lease Name Cooper Well No. #1 (C1-6)

Office Address 725 Union Center Bldg, Wichita, Kansas

Character of Well (completed as Oil, Gas or Dry Hole) Dry Hole

Date well completed May 20, 19 71

Application for plugging filed May 20 19 71

Application for plugging approved May 20 19 71

Plugging commenced May 20 19 71

Plugging completed May 20 19 71

Reason for abandonment of well or producing formation Dry Hole

If a producing well is abandoned, date of last production 19 _____

Was permission obtained from the Conservation Division or its agents before plugging was commenced? Yes

Name of Conservation Agent who supervised plugging of this well Edgar Eves

Producing formation _____ Depth to top _____ Bottom _____ Total Depth of Well 5850 Feet

Show depth and thickness of all water, oil and gas formations.

OIL, GAS OR WATER RECORDS

CASING RECORD

FORMATION	CONTENT	FROM	TO	SIZE	PUT IN	PULLED OUT
				8 5/8"	1604'	None

Describe in detail the manner in which the well was plugged, indicating where the mud fluid was placed and the method or methods used in introducing it into the hole. If cement or other plugs were used, state the character of same and depth placed, from _____ feet to _____ feet for each plug set.

Spotted 35 sks cem @ 1000' 15 sks @ 45'
Plugged by Howco

RECEIVED
STATE CORPORATION COMMISSION
JUN 3 1971
CONSERVATION DIVISION
Wichita, Kansas

(If additional description is necessary, use BACK of this sheet)

Name of Plugging Contractor: Leben Drilling, Inc.
Address: 100 Park Avenue Building, Suite 333, Oklahoma City, Oklahoma

STATE OF OKLAHOMA, COUNTY OF OKLAHOMA, ss.
Leslie Kite

(employee of owner) or (owner or operator) of the above-described well, being first duly sworn on oath, says: That I have knowledge of the facts, statements, and matters herein contained and the log of the above-described well as filed and that the same are true and correct. So help me God.

(Signature) Leslie Kite

100 Park Ave Bldg Okla. City, Okla.
(Address)

SUBSCRIBED AND SWORN TO before me this 2nd day of June, 1971


My commission expires 4-29-75

[Signature]
Notary Public.

WELL LOG

Company Lee Banks
Contractor Leben Drilling, Inc.
Farm Cooper #1 (1-6)
Total Depth 5850
Commenced May 5, 1971
Completed May 20, 1971

Sec. 6 T. 33S R. 33W
Loc. C NE NE
County Seward County, Kansas
Casing 8 5/8" @ 1604'
Production 5 1/2"

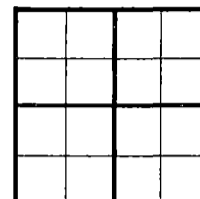

Figures Indicate Bottom of Formations

- 0 - 72' Sd Shells
- 72 - 1370' Sd & Red Bed
- 1370 - 1604' Red Bed - Anhy
- 1604 - 2450' Anhy & Sh
- 2450 - 2788' Lm & Sh
- 2788 - 2912' Anhy
- 2912 - 5418' Lm & Sh
- 5418 - 5850' Sh & Lm

RECEIVED
STATE CORPORATION COMMISSION
JUN 3 1971
CONSERVATION DIVISION
Wichita, Kansas

State of OKLAHOMA
County of OKLAHOMA } SS

I, Leslie Kite of Leben Drilling, Inc., upon oath state that the above and foregoing is a true and correct copy of the log of the Cooper #1 Well.

Leslie Kite

Subscribed and sworn to before me this 2nd day of June, 1971

My Commission Expires: 4-29-75

Thomas A. Thompson