

STATE OF KANSAS
STATE CORPORATION COMMISSION

Give All Information Completely
Make Required Affidavit
Mail or Deliver Report to:
Conservation Division
State Corporation Commission
211 No. Broadway
Wichita, Kansas

WELL PLUGGING RECORD

Seward County, Sec. 14 Twp. 33S Rge. 32W (E) (W)

Location as "NE/CNW/SW" or footage from lines CSW NE

Lease Owner Richard King, Jr.

Lease Name Alexander Well No. 1

Office Address Box 1008 - McAllen, Texas

Character of Well (completed as Oil, Gas or Dry Hole)

Date well completed 19

Application for plugging filed 19

Application for plugging approved 19


Plugging commenced February 5 19 57

Plugging completed February 8 19 57

Reason for abandonment of well or producing formation

If a producing well is abandoned, date of last production 19

Was permission obtained from the Conservation Division or its agents before plugging was commenced? Yes

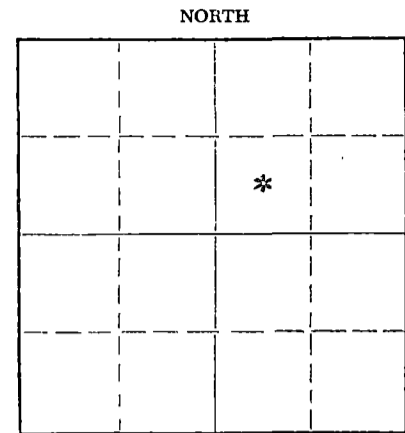

Locate well correctly on above Section Plat

Name of Conservation Agent who supervised plugging of this well Merle Rives

Producing formation Depth to top Bottom Total Depth of Well 6034 Feet

Show depth and thickness of all water, oil and gas formations.

OIL, GAS OR WATER RECORDS

CASING RECORD

FORMATION	CONTENT	FROM	TO	SIZE	PUT IN	PULLED OUT
				8-5/8"	2610'	None
				5-1/2"	6079'	3121'
				13-3/8"	548'	None
				Plugged back to 5840' and perforated from 5809' to 5814'.		

Describe in detail the manner in which the well was plugged, indicating where the mud fluid was placed and the method or methods used in introducing it into the hole. If cement or other plugs were used, state the character of same and depth placed, from feet to feet for each plug set.

Had Halliburton set a bridging plug at 5800' and ran 8 sacks of cement on plug. Pulled casing up to 1800' and circulated the hole with 25 sacks of jell mud. Mudded the hole to 500', set a 10' rock bridge and ran 30 sacks of cement. Mudded the hole to 35', set a 10' rock bridge and ran 10 sacks of cement on top. Plugging completed.

(If additional description is necessary, use BACK of this sheet)

Name of Plugging Contractor West Supply Co., Inc.

Address Chase, Kansas


STATE OF Texas COUNTY OF Seward, ss. Richard King, Jr. (employee of owner) or (owner or operator) of the above-described well, being first duly sworn on oath, says: That I have knowledge of the facts, statements, and matters herein contained and the log of the above-described well as filed and that the same are true and correct. So help me God.

(Signature) Richard King, Jr. Box 2008 McAllen, Texas (Address)

SUBSCRIBED AND SWORN to before me this 27 day of February, 1957

My commission expires June 1, 1957

Lutha Flowers Notary Public.

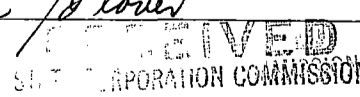

PLUGGING FILE SEC 14 T 33 R 32W BOOK PAGE 138 LINE 40

MAR 18 1957

CONSERVATION DIVISION Wichita, Kansas