


WELL PLUGGING RECORD

Give All Information Completely
Make Required Affidavit
Mail or Deliver Report to:
Conservation Division
State Corporation Commission
212 No. Market
Wichita, Kansas

Seward County, Sec. 27 Twp. 33 Rge. 31 (X) (W)

Location as "NE/CNW/SW" or footage from lines NE SE
Lease Owner Thomas & Brewer
Lease Name Eaton Well No. 1
Office Address Box 1177, Liberal, Kansas
Character of Well (completed as Oil, Gas or Dry Hole) Gas
Date well completed 8-29 19 60
Application for plugging filed 1-28 19 67
Application for plugging approved 2-2 19 67
Plugging commenced 2-11 19 67
Plugging completed 2-12 19 67
Reason for abandonment of well or producing formation Non commercial
If a producing well is abandoned, date of last production 3-23 19 66
Was permission obtained from the Conservation Division or its agents before plugging was commenced? Yes

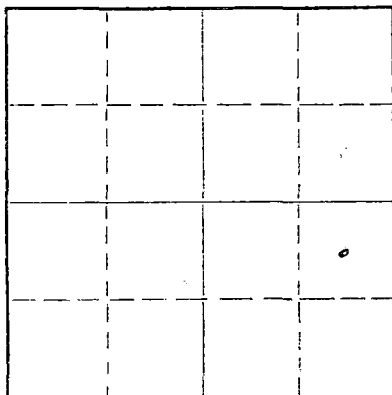

Locate well correctly on above Section Plat

Name of Conservation Agent who supervised plugging of this well Ed Eves
Producing formation Council Grove Depth to top 2987 Bottom 3325 Total Depth of Well 3380 Feet
Show depth and thickness of all water, oil and gas formations.

OIL, GAS OR WATER RECORDS

CASING RECORD

FORMATION	CONTENT	FROM	TO	SIZE	PUT IN	PULLED OUT
Surface sand	Fresh water	45	385	8 5/8 4 1/2	1466 3410	0 2609

Describe in detail the manner in which the well was plugged, indicating where the mud fluid was placed and the method or methods used in introducing it into the hole. If cement or other plugs were used, state the character of same and depth placed, from _____ feet to _____ feet for each plug set.

Mix 15 sacks cement and 1 sack hulls to plug off perforations. Stop plug at 2900 feet. Shoot pipe loose at 2609 feet and pull same. Pump 40 sacks cement at 700 to 600 feet. Fill with mud to 35 feet and put 10 sacks cement at 35 feet to 0 feet. Cut off and cap 8 5/8.

RECEIVED
STATE CORPORATION COMMISSION

FEB 23 1967

CONSERVATION DIVISION
Wichita, Kansas

(If additional description is necessary, use BACK of this sheet)
Name of Plugging Contractor Sargent's Casing Pulling Service
Address Box 506, Liberal, Kansas

STATE OF Kansas, COUNTY OF Seward, ss.
Delvin P. Luck (employee of owner) or (owner or operator) of the above-described

well, being first duly sworn on oath, says: That I have knowledge of the facts, statements, and matters herein contained and the log of the above-described well as filed and that the same are true and correct. So help me God.

(Signature) Delvin P. Luck
Box 1177, Liberal, Kansas
(Address)

SUBSCRIBED AND SWORN TO before me this 21 day of February, 19 67

My commission expires 11-5-70
Notary Public.

THOMAS & BREWER
WELL #1

C NE SE Sec. 27-33-31W
Seward County, Kansas

RTD 6100'

CONTRACTOR: Bennett & Roberts Drilling Co.

Commenced 7/9/60
Completed 8/5/60

Set 3 5/8" @ 1466' w/650 sz cmt
Set 4 1/2" @ 3410' w/175 sz cmt

Surface Soil & Sand	130
Sand	385
Shale & Shells	430
Sand & Shells	606
Red Bed & Shale	900
Sand	1050
Red Bed & Shells	1130
Red Bed & Shale, Anhydrite	1235
Red Bed & Shale	1458
Anhydrite	1466
Red Bed & Anhydrite	1484
Red Bed & Shale	1780
Shale & Shells	1830
Shale & Lime Streaks	2259
Lime & Shale	2400
Lime	2916
Lime & Shale	3016
Lime	3130
Lime & Shale	3225
Lime & Chalk	3539
Lime & Shale	3636
Lime & Chalk	3715
Lime & Shale	3842
Lime	4917
Lime & Shale	4990
Lime	5475
Lime & Shale	5535
Lime	5626
Lime & Shale	5670
Lime	6100

RECEIVED
STATE CORPORATION COMMISSION

AUG 22 1967

CONSERVATION DIVISION
Topeka, Kansas

STATE OF KANSAS)
RUSSELL COUNTY) SS.

I hereby certify that the above information is correct to the best of my knowledge.

BENNETT & ROBERTS DRILLING CO.

By Janice Lee Marshall

Subscribed and sworn to before me this 9th day of August, 1960.

By Chris Jensen
Notary Public

My Commission Expires 6/17/62