


STATE OF KANSAS
STATE CORPORATION COMMISSION

Give All Information Completely
Make Required Affidavit
Major Deliver Report to:
Conservation Division
State Corporation Commission
211 No. Broadway
Wichita, Kansas

WELL PLUGGING RECORD

NORTH

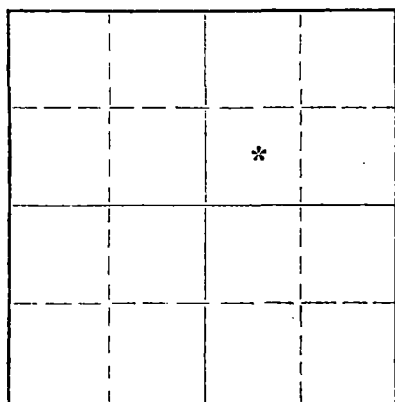

Locate well correctly on above
Section Plat

Seward County. Sec. 33 Twp. 33S Rge. 31W (E) (W)
Location as "NE/CNW/SW" or footage from lines 1980' from North & East Lines
Lease Owner Cabot Corporation
Lease Name Eaton-Griffith Well No. 1
Office Address P. O. Box 1101, Pampa, Texas
Character of Well (completed as Oil, Gas or Dry Hole) Dry Hole
Date well completed October 20 19 62
Application for plugging filed October 23 19 62
Application for plugging approved October 23 19 62
Plugging commenced October 20 19 62
Plugging completed 9:00 p. m. October 20 19 62
Reason for abandonment of well or producing formation Dry Hole

If a producing well is abandoned, date of last production _____ 19____
Was permission obtained from the Conservation Division or its agents before plugging was commenced? Yes

Name of Conservation Agent who supervised plugging of this well Hugh Scott
Producing formation _____ Depth to top _____ Bottom _____ Total Depth of Well _____ Feet
Show depth and thickness of all water, oil and gas formations.

OIL, GAS OR WATER RECORDS

CASING RECORD

FORMATION	CONTENT	FROM	TO	SIZE	PUT IN	PULLED OUT
				8-5/8"	2408	None

Describe in detail the manner in which the well was plugged, indicating where the mud fluid was placed and the method or methods used in introducing it into the hole. If cement or other plugs were used, state the character of same and depth placed, from _____ feet to _____ feet for each plug set.

Circulate heavy mud on bottom for one hour. Halliburton spotted 25 sacks Pozmix 6116'-6025'. Mud from 6025' to 4559'. Halliburton spotted 25 sacks Pozmix from 4559' to 4460'. Mud from 4460' to 818'. Push Halliburton plug to 818'. Halliburton spotted 35 sacks Pozmix 818' to 700'. Mud from 700' to 48'. Halliburton spotted 15 sacks Pozmix 48' to 4'. Cut 8-5/8" casing off 4' below ground and welded on metal cap.

STATE CORPORATION COMMISSION

OCT 30 1962

CONSERVATION DIVISION
Wichita, Kansas

(If additional description is necessary, use BACK of this sheet)
Name of Plugging Contractor George B. McClellan Drilling Company
Address P. O. Box 1226, Liberal, Kansas

STATE OF Texas, COUNTY OF Gray, ss.
G. M. Martin (employee of owner) or (owner or operator) of the above-described well, being first duly sworn on oath, says: That I have knowledge of the facts, statements, and matters herein contained and the log of the above-described well as filed and that the same are true and correct. So help me God.
(Signature) G. M. Martin Production Superintendent
P. O. Box 1101, Pampa, Texas (Address)

SUBSCRIBED AND SWORN to before me this 26th day of October, 1962

My commission expires 6-1-63
Mary K. Jaynes Mary K. Jaynes Notary Public.



RECEIVED
STATE CORPORATION COMMISSION

OCT 24 1962

CONSERVATION DIVISION
Wichita, Kansas

DRILLER'S LOG OF EATON-GRIFFITH NO. 1 Well

0	to	200'	Sand and gravel
		800	Sand and red rock
		1420	Red rock
		1900	Red rock and broken anhydrite
		2200	Red and gray shale
		2590	Anhydrite and gray shale
		2910	Dolomite and lime
		3300	Broken lime
		3735	Shale and chalky lime
		4285	Shale and broken lime
		4470	Broken lime
		5125	Gray and brown lime
		5610	Gray shale and lime
		5825	Shale and lime streaks
		5995	Gray lime
		6047	Sandy lime
		6260	White lime
		6330	Gray lime
		6330'	Driller's Total Depth
		6327'	Log Total Depth

FORMATION TOPS

2600'	Herington
2634	Krider
2728	Winfield
2792	Ft. Riley
3014	Council Grove
4335	Base Heebner
4357	Toronto
4474	Lansing
5004	Checkerboard
5134	Marmaton
5296	Cherokee
5652	Morrow
5759	Chester
6046	St. Genevieve
6140	St. Louis