


STATE OF KANSAS
STATE CORPORATION COMMISSION
Give All Information Completely
Make Required Affidavit
Mail or Deliver Report to:
Conservation Division
State Corporation Commission
211 No. Broadway
Wichita, Kansas

WELL PLUGGING RECORD

SEWARD ^{SW NE} County. Sec. 33 Twp. 33 Rge. 31W (E) (W)

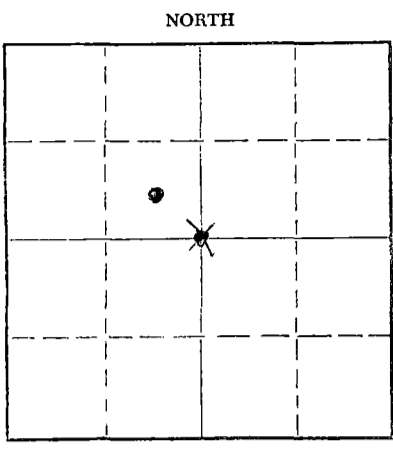

Location as "NE/CNW/SW" or footage from lines _____
Lease Owner RAINBOW EXPLORATION INCORPORATED
Lease Name EATON-GRIFFITH Well No. 1
Office Address 1001 UNION CENTER WICHITA KANSAS
Character of Well (completed as Oil, Gas or Dry Hole) Dry hole
Date well completed MARCH 11 1963
Application for plugging filed MARCH 11 1963
Application for plugging approved MARCH 11 1963
Plugging commenced MARCH 11 1963
Plugging completed 8:30 P.M. MARCH 11 1963
Reason for abandonment of well or producing formation NON COMMERCIAL

If a producing well is abandoned, date of last production _____ 19____
Was permission obtained from the Conservation Division or its agents before plugging was commenced? YES

Name of Conservation Agent who supervised plugging of this well Hugh Scott
Producing formation NONE Depth to top _____ Bottom _____ Total Depth of Well 4527 Feet
Show depth and thickness of all water, oil and gas formations.

OIL, GAS OR WATER RECORDS CASING RECORD

FORMATION	CONTENT	FROM	TO	SIZE	PUT IN	PULLED OUT
<u>NONE KNOWN</u>				<u>8 5/8</u>	<u>2420</u>	<u>NONE</u>
				<u>4 1/2</u>	<u>4518</u>	<u>2605</u>

Describe in detail the manner in which the well was plugged, indicating where the mud fluid was placed and the method or methods used in introducing it into the hole. If cement or other plugs were used, state the character of same and depth placed, from _____ feet to _____ feet for each plug set.

8 5/8 To 2420 Circulated w/ cement Mud From 4527 To 2605 Pipe Shot Loose AT 2605 AND 25 SKS CEMENT pumped From 2605 To 2500 FT. Mud From 2500 To 700 - 35 SKS CEMENT pumped From 700 To 600 - Mud From 600 To 40' - 15 SKS CEMENT From 40' To 0 - Weld Cap ON 8 5/8 CASING 3' Below ground level.
Plugs pumped w/ cementing Truck

RECEIVED
STATE CORPORATION COMMISSION

MAR 13 1963

CONSERVATION DIVISION
WICHITA, KANSAS

(If additional description is necessary, use BACK of this sheet)

Name of Plugging Contractor SARGENTS CASING Pulling Service.
Address 121 West 9th Liberal KANSAS

STATE OF Kansas, COUNTY OF Seward, ss.

(employee of owner) or (owner or operator) of the above-described well, being first duly sworn on oath, says: That I have knowledge of the facts, statements, and matters herein contained and the log of the above-described well as filed and that the same are true and correct. So help me God.

(Signature) Channing C. McAllister
1515 CARTER Liberal KAN
(Address)

SUBSCRIBED AND SWORN to before me this 11th day of March, 1963

Marlene Keating
Notary Public.

My commission expires 11-5-1966



INVOICED

DATE 3/13/63

INV. NO. 6715-W