


WELL PLUGGING RECORD

Give All Information Completely
Make Required Affidavit
Mail or Deliver Report to:
Conservation Division
State Corporation Commission
212 No. Market
Wichita, Kansas

NORTH

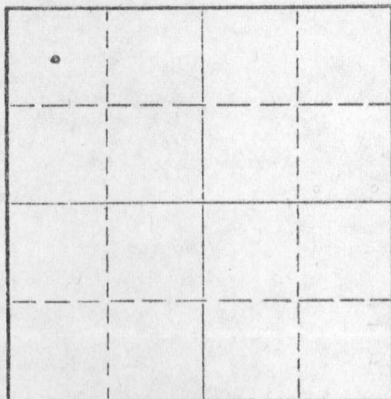

Locate well correctly on above
Section Plat

Seward County, Sec. 34 Twp. 33S Rge. (E) 31(W)

Location as "NE/CNW/SW" or footage from lines 50' S. of C-NW NW

Lease Owner Allied Materials Corp.

Lease Name Ormiston Well No. 1-A

Office Address P.O. Box 12340, Oklahoma City, OK 73112

Character of Well (completed as Oil, Gas or Dry Hole) Gas

Date well completed June 5 19 75

Application for plugging filed September 27 19 78

Application for plugging approved October 2 19 78

Plugging commenced October 20 19 78

Plugging completed October 25 19 78

Reason for abandonment of well or producing formation Non-Commercial

If a producing well is abandoned, date of last production July 1 19 75

Was permission obtained from the Conservation Division or its agents before plugging was commenced? Yes

Name of Conservation Agent who supervised plugging of this well Clarence Thomas

Producing formation Herington Depth to top 2584 Bottom 2640 Total Depth of Well 2648 Feet

Show depth and thickness of all water, oil and gas formations.

OIL, GAS OR WATER RECORDS

CASING RECORD

FORMATION	CONTENT	FROM	TO	SIZE	PUT IN	PULLED OUT
Herington		2584'	2640'	8-5/8"	587'	None
				4-1/2"	2648'	2028.85'

Describe in detail the manner in which the well was plugged, indicating where the mud fluid was placed and the method or methods used in introducing it into the hole. If cement or other plugs were used, state the character of same and depth placed, from _____ feet to _____ feet for each plug set.

Pumped 20 sx. cement w/2 sx. cotton seed hulls to 2300' w/mud laden fluid. Pipe was shot free @ 2030' & pulled up to 630'. A 35sx. cement plug was pumped from 630' to 530'. Finished pulling pipe. Capped well w/15 sx. cement from 40' to top. Cut off surface pipe & welded on steel plate.

RECEIVED
STATE CORPORATION COMMISSION
DEC - 4 1978
CONSERVATION DIVISION
Wichita, Kansas

(If additional description is necessary, use BACK of this sheet)

Name of Plugging Contractor Reeves & Wilson, Inc.

Address P.O. Box 94204, Oklahoma City, OK 73143

STATE OF Oklahoma, COUNTY OF Lincoln, ss. T. W. Peek

(employee of owner) or (owner or operator) of the above-described well, being first duly sworn on oath, says: That I have knowledge of the facts, statements, and matters herein contained and the log of the above-described well as filed and that the same are true and correct. So help me God.

(Signature) T. W. Peek

305 W. 3rd St., Stroud, OK 74079 (Address)

SUBSCRIBED AND SWORN TO before me this 2nd day of November, 19 78

My commission expires June 15, 1982

Margaret Mae Culey Notary Public.