


STATE OF KANSAS
STATE CORPORATION COMMISSION

Give All Information Completely
Make Required Affidavit
Mail or Deliver Report to:
Conservation Division
State Corporation Commission
800 Biting Building
Wichita, Kansas

WELL PLUGGING RECORD

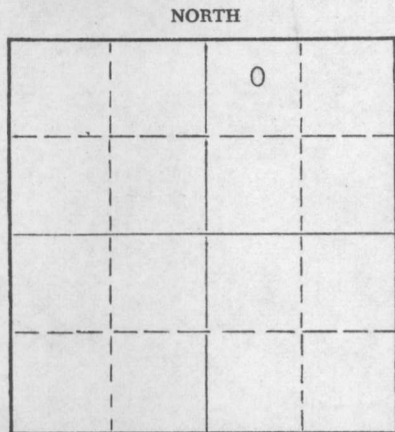

Locate well correctly on above
Section Plat

Meade County. Sec. 15 Twp. 33 Rge. 30 (E) (W)
Location as "NE/CNW/SE/SW" or footage from lines 1,980' from east, 660' from north.
Lease Owner THE SHAMROCK OIL AND GAS CORPORATION
Lease Name Clara Vail et al Well No. 2
Office Address Box 631, Amarillo, Texas
Character of Well (completed as Oil, Gas or Dry Hole) Dry Hole
Date well completed November 24 1955
Application for plugging filed November 23 1955
Application for plugging approved November 24 1955
Plugging commenced November 24 1955
Plugging completed November 24 1955
Reason for abandonment of well or producing formation Dry Hole

If a producing well is abandoned, date of last production - 19-
Was permission obtained from the Conservation Division or its agents before plugging was commenced? Yes

Name of Conservation Agent who supervised plugging of this well Merle Rives
Producing formation None Depth to top - Bottom - Total Depth of Well 5,803 Feet
Show depth and thickness of all water, oil and gas formations.

OIL, GAS OR WATER RECORDS

CASING RECORD

FORMATION	CONTENT	FROM	TO	SIZE	PUT IN	PULLED OUT
Sand and red beds	water	0	610	13 3/8" OD	637	None

Describe in detail the manner in which the well was plugged, indicating where the mud fluid was placed and the method or methods used in introducing it into the hole. If cement or other plugs were used, state the character of same and depth placed, from _____ feet to _____ feet for each plug set.

Plugged back from 5,803' to 635' with heavy mud.
Pushed 13 3/8" Halliburton plug to 635'.
Spotted 35 sacks cement from 635' to 595'.
Spotted heavy mud, from 595' to 23'.
Pushed 13 3/8" Halliburton plug to 23'.
Spotted 15 sacks cement from 23' to surface.

RECEIVED
STATE CORPORATION COMMISSION
NOV 28 1955
CONSERVATION DIVISION
Wichita, Kansas

(If additional description is necessary, use BACK of this sheet)
Name of Plugging Contractor Halliburton Oil Well Cementing Company
Address Great Bend, Kansas

STATE OF Texas, COUNTY OF Potter, ss.
T. S. Clopton (employee of owner) or (~~owner or operator~~) of the above-described well, being first duly sworn on oath, says: That I have knowledge of the facts, statements, and matters herein contained and the log of the above-described well as filed and that the same are true and correct. So help me God.

(Signature) T. S. Clopton
Box 631, Amarillo, Texas
(Address)

SUBSCRIBED AND SWORN TO before me this 25th day of November, 1955

Dorris Richardson
DORRIS RICHARDSON
NOTARY PUBLIC
Notary Public.

My commission expires 6-1-57

PLUGGING
FILE REC-15 T 33 R 30 W
BOOK PAGE 19 LINE 22

LOG OF

Sec 15-33-30W

THE SHAMROCK OIL AND GAS CORPORATION

Clara Vail et al No. 2

0'	-	610'	Sand, shells, and clay
610'	=	2,670'	Red beds, salt, anhydrite
2,670'	-	2,875'	Dolomite
2,875'	-	3,925'	Lime
3,925'	-	5,803'	Lime and shale

MILLERS FALLS
 OLD DEER FIELD BOND
 50% COTTON CONTENT

PLUGGING
 FILE SEC 15 T 33 R 30 W
 BOOK PAGE 69 LINE 32

RECEIVED
 STATE CORPORATION COMMISSION
 NOV 28 1955
 CONSERVATION DIVISION
 Wichita, Kansas