


STATE OF KANSAS  
STATE CORPORATION COMMISSION

Give All Information Completely  
Make Required Affidavit  
Mail or Deliver Report to:  
Conservation Division  
State Corporation Commission  
800 Bittig Building  
Wichita, Kansas

WELL PLUGGING RECORD

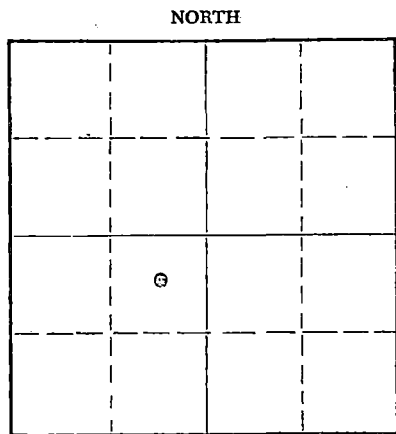

Locate well correctly on above  
Section Plat

Meade County, Sec. 16 Twp. 33S Rge. 30 (K) (W)  
Location as "NE/CNW/SW" or footage from lines 1980' fr. South, 1980' fr. West  
Lease Owner The Shamrock Oil and Gas Corp.  
Lease Name Bruno Meyer "A" Well No. 1  
Office Address Box 631, Amarillo, Texas  
Character of Well (completed as Oil, Gas or Dry Hole) Dry  
Date well completed January 23, 19 57  
Application for plugging filed January 18, 19 57  
Application for plugging approved January 24, 19 57  
Plugging commenced February 1, 19 57  
Plugging completed February 8, 19 57  
Reason for abandonment of well or producing formation Dry

If a producing well is abandoned, date of last production --- 19  
Was permission obtained from the Conservation Division or its agents before plugging was commenced? Yes

Name of Conservation Agent who supervised plugging of this well Merle Rives  
Producing formation None Depth to top --- Bottom --- Total Depth of Well 5829 Feet  
Show depth and thickness of all water, oil and gas formations.

OIL, GAS OR WATER RECORDS

CASING RECORD

FORMATION	CONTENT	FROM	TO	SIZE	PUT IN	PULLED OUT
Sandy shale		550'	700'	9 5/8"	2692.61'	-0-
Sand		700	860	7"	5833.33	3013.36
Sand & shale		1,500	1,640			
Sand & shale		1,800	1,870			
Sand & shale		5,640	5,715			
Sand		5,785	5,790			

Describe in detail the manner in which the well was plugged, indicating where the mud fluid was placed and the method or methods used in introducing it into the hole. If cement or other plugs were used, state the character of same and depth placed, from --- feet to --- feet for each plug set.  
Plugged back with gravel & sand from 5,797' to 5,700'. Dumped 5 sacks cement at 5,700'. Put in 17 sacks cement at 5,650'. Plugged back with sand and 10 sacks cement to 5,550'. Shot 7" casing loose at 3,001'. Pulled 3,013.36' of 7" casing. Circulated rotary mud from 5,550' to 550'. Spotted 25 sacks cement at 550'. Spotted 10 sacks cement in top of 9 5/8" OD surface casing. Completed as dry and abandoned.

RECEIVED  
STATE CORPORATION COMMISSION

FEB 14 1957

CONSERVATION DIVISION  
Wichita, Kansas

Name of Plugging Contractor Forbes Casing Pulling Unit  
Address Great Bend, Kansas.

STATE OF TEXAS, COUNTY OF POTTER, ss.  
T. S. Clopton (employee of owner) or (owner or operator) of the above-described

well, being first duly sworn on oath, says: That I have knowledge of the facts, statements, and matters herein contained and the log of the above-described well as filed and that the same are true and correct. So help me God.

(Signature) T. S. Clopton

Box 631, Amarillo, Texas (Address)

SUBSCRIBED AND SWORN TO before me this 13th day of February, 19 57

PAULINE POWELL  
Notary Public  
Potter County, Texas  
Notary Public.

My commission expires 6-1-57

PLUGGING  
FILE SEC 16 T. 33 R 30. W  
BOOK PAGE 134 L 33

BRUNO MEYER "A" NO. 1  
Section 16, Township 33S, Range 30 West

0' - 400'	Surface and sand
400 - 550	Sandy lime
550 - 700	Sandy shale
700 - 860	Sand
860 - 1,185	Anhydrite and sand
1,185 - 1,350	Red bed and sand
1,350 - 1,500	Anhydrite and shale
1,500 - 1,640	Sand and shale
1,640 - 1,800	Sand and anhydrite
1,800 - 1,870	Sand and shale
1,870 - 2,110	Anhydrite, dolomite and salt
2,110 - 2,400	Anhydrite and salt
2,400 - 2,580	Anhydrite
2,580 - 2,920	Dolomite
2,920 - 4,000	Lime and shale streaks
4,000 - 4,090	Shale
4,090 - 4,130	Lime
4,130 - 4,165	Shale
4,165 - 4,300	Lime and shale
4,300 - 4,380	Shale and lime streaks
4,380 - 4,525	Lime
4,525 - 4,545	Shale
4,545 - 5,010	Lime
5,010 - 5,040	Shale
5,040 - 5,230	Lime
5,230 - 5,250	Shale
5,250 - 5,300	Lime
5,300 - 5,320	Shale
5,320 - 5,640	Lime and shale streaks
5,640 - 5,715	Sand and shale
5,715 - 5,730	Lime
5,730 - 5,750	Lime, sand and shale
5,750 - 5,765	Lime and sand
5,765 - 5,785	Shale
5,785 - 5,790	Sand
5,790 - 5,829	Lime

RECEIVED  
STATE CORPORATION COMMISSION

PLUGGING JAN 21 1957  
 REC. SEC. 16 T. 33 R. 30 W.  
 CONSERVATION DIVISION  
 BOOK PAGE 134 LINE 33 Wichita, Kansas