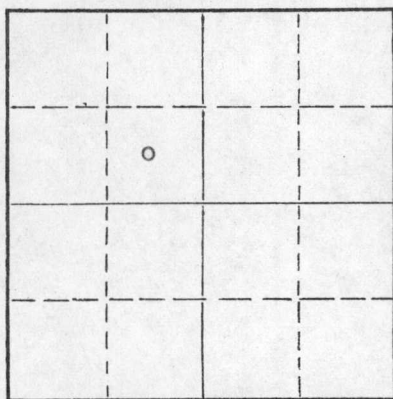


STATE OF KANSAS
STATE CORPORATION COMMISSION

Give All Information Completely
Make Required Affidavit
Mail or Deliver Report to:
Conservation Division
State Corporation Commission
800 Bitting Building
Wichita, Kansas

WELL PLUGGING RECORD

NORTH

Locate well correctly on above
Section Plat

Meade County. Sec. 17 Twp. 33 Rge. 30 (E) (W)
Location as "NE/CNW/SW" or footage from lines 1980' fr. N; 1980' fr. W
Lease Owner The Shamrock Oil and Gas Corporation
Lease Name Patterson Well No. 1
Office Address Box 631, Amarillo, Texas
Character of Well (completed as Oil, Gas or Dry Hole) Dry Hole
Date well completed October 19, 1955
Application for plugging filed October 19, 1955
Application for plugging approved October 19, 1955
Plugging commenced October 19, 1955
Plugging completed October 19, 1955
Reason for abandonment of well or producing formation Dry Hole

If a producing well is abandoned, date of last production Dry Hole 19
Was permission obtained from the Conservation Division or its agents before plugging was commenced? Yes

Name of Conservation Agent who supervised plugging of this well Merle Rives
Producing formation None Depth to top Bottom Total Depth of Well 5770 Feet
Show depth and thickness of all water, oil and gas formations.

OIL, GAS OR WATER RECORDS

CASING RECORD

FORMATION	CONTENT	FROM	TO	SIZE	PUT IN	PULLED OUT
Water gravel - Gravel	Fresh water	0	575	13 3/8"	640	None
				9 5/8"	2630	None

Describe in detail the manner in which the well was plugged, indicating where the mud fluid was placed and the method or methods used in introducing it into the hole. If cement or other plugs were used, state the character of same and depth placed, from feet to feet for each plug set.

5,770' to 650' Heavy mud
650' Halliburton plug (9 5/8")
650' to 562' Cement (35 sacks)
562' to 30' Heavy mud
30' Halliburton plug (9 5/8")
30' to 0' Cement (15 sacks)

(If additional description is necessary, use BACK of this sheet)

Name of Plugging Contractor Halliburton Oil Well Cementing Company
Address Liberal, Kansas

STATE OF TEXAS, COUNTY OF POTTER, SS.
Dan P. Long (employee of owner) or (owner or operator) of the above-described well, being first duly sworn on oath, says: That I have knowledge of the facts, statements, and matters herein contained and the log of the above-described well as filed and that the same are true and correct. So help me God.


(Signature)

Box 631, Amarillo, Texas

(Address)

SUBSCRIBED AND SWORN TO before me this 24th day of October, 1955

My commission expires June 1, 1957

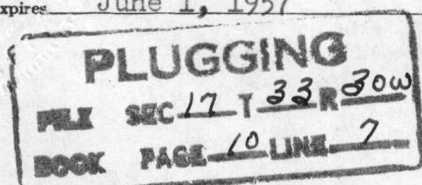Pauline Powell
Potter County, TexasPAULINE POWELL
Notary Public.

OCT 25 1955

CONSERVATION DIVISION
Wichita, Kansas

THE SHAMROCK OIL AND GAS CORPORATIONPATTERSON NO. 1(Section 17, Township 33 South, Range
30 West, Meade County, Kansas)

0' - 570'	Sand
575' - 860'	Sand and shale
860' - 1,190'	Anhydrite and sand
1,190' - 1,600'	Shale and anhydrite
1,600' - 2,600'	Salt, anhydrite, and shale
2,600' - 2,850'	Dolomite
2,850' - 5,770'	Lime and shale.

PLUGGING
 FILE SEC 17 T. 33 R. 30 W.
 BOOK PAGE 40 LINE 7

RECEIVED
 STATE CORPORATION COMMISSION

OCT 24 1955

CONSERVATION DIVISION
 Wichita, Kansas