

STATE OF KANSAS  
STATE CORPORATION COMMISSION

WELL PLUGGING RECORD

Give All Information Completely  
Make Required Affidavit  
Mail or Deliver Report to:  
Conservation Division  
State Corporation Commission  
800 Bitting Building  
Wichita, Kansas

Meade County, Sec. 17 Twp. 33 Rge. 30 (E) (W)

Location as "NE/CNW 1/4 SW 1/4" or footage from lines 1980' from West; 1980' from South

Lease Owner Columbian Fuel Corporation

Lease Name Grace Patterson Well No. 1

Office Address Drawer 31, Liberal, Kansas

Character of Well (completed as Oil, Gas or Dry Hole) Dry Hole

Date well completed March 5 1954

Application for plugging filed June 23 1954

Application for plugging approved June 24 1954


Plugging commenced July 9 1954

Plugging completed July 13 1954

Reason for abandonment of well or producing formation Dry

If a producing well is abandoned, date of last production None 19    

Was permission obtained from the Conservation Division or its agents before plugging was commenced? Yes

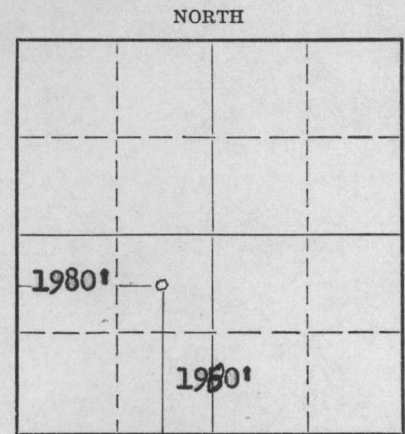

Locate well correctly on above Section Plat

Name of Conservation Agent who supervised plugging of this well M. A. Rives

Producing formation None Depth to top      Bottom      Total Depth of Well 5927 Feet

Show depth and thickness of all water, oil and gas formations.

OIL, GAS OR WATER RECORDS

CASING RECORD

Formation	Content	From	To	Size	Put In	Pulled Out
				13 3/8"	641'	None
				8 5/8"	2630'	911
				5 1/2"	5770'	2832'

Describe in detail the manner in which the well was plugged, indicating where the mud fluid was placed and the method or methods used in introducing it into the hole. If cement or other plugs were used, state the character of same and depth placed, from      feet to      feet for each plug set.

- Perforations 5721 - 5730 - Squeezed w/70 gal. plastic
- " 5699 - 5712
- " 5673 - 5677
- " 5691 - 5696 - Baker Bridge Plug @ 5187'
- " 5145 - 5149 - Squeezed w/30 gal. plastic
- " 5132 - 5136 - Baker Bridge Plug @ 4882'
- " 4854 - 4858 - Baker Bridge Plug @ 4622'
- " 4586 - 4592 - Squeeze 30 gal plastic
- " 4437 - 4447 - Squeeze 30 gal plastic
- " 4397 - 4412 - Baker Bridge Plug @ 4375'
- " 4330 - 4344 - Squeezed w/25 Sacks Cement
- " 2700 - 4209 - Mud. (Top of cement 4209')
- 2700' - 15 sacks cement
- 540' - 2700' Filled w/mud
- 540' - Rock bridge
- 500' - 540' - 35 Sacks cement
- 12' - 500' - Filled with mud.
- 0 - 12' - 15 sacks cement

(If additional description is necessary, use BACK of this sheet)

Name of Plugging Contractor Daco Lease and Well Service, G. D. Davis

Address Borger, Texas

STATE OF Kansas, COUNTY OF Seward, ss. I, Harvey H. Hagens (employee of owner) or (owner or operator) of the above-described well,

being first duly sworn on oath, says: That I have knowledge of the facts, statements, and matters herein contained and the log of the above-described well as filed and that the same are true and correct. So help me God.

(Signature) Harvey H. Hagens  
Harvey H. Hagens  
Drawer 31, Liberal, Kansas (Address)

SUBSCRIBED AND SWORN to before me this 9th day of August, 1954

Wallace B. Pedigo  
Notary Public.

My commission expires 6-4-55

PLUGGING  
FILE SEC 17 T 33 R 30W  
BOOK PAGE 43 LINE 24

AUG 10 1954  
CONSERVATION DIVISION  
Wichita, Kansas

# LOG OF WELL

CODE GW 2043 Columbian Fuel Corp SHEET \_\_\_\_\_  
 (COMPANY)  
 STATE Kansas DISTRICT 72 COUNTY Meade  
 LEASE Grace Patterson WELL NO. 1 SEC. 17 TWP. 33 R. 30  
 DATE OF LOG 10-12-53 LOCATION IN SEC. 1980' From West & 1980' From South Lines  
 LOCATION MADE 4-16-53 COMM. RIGGING UP 4-23-53 COMM. DRILLING 4-23-53 COMP. DRILLING 5-28-53  
 TOTAL DEPTH 5927' ELEVATION 2731.4' Ground STATE PERMIT NO. \_\_\_\_\_  
 DAY DRILLER Bill Jones NIGHT DRILLER J.W. Gardiner CONTRACTOR Helmerich & Payne Inc.  
 CABLE TOOLS FROM \_\_\_\_\_ TO \_\_\_\_\_ ROTARY TOOLS FROM 0 TO 5927'  
 OPEN FLOW CAPACITY \_\_\_\_\_ M. CU. FT. ROCK PRESSURE \_\_\_\_\_ GASOLINE CONTENT \_\_\_\_\_  
 PER M. CU. FT. \_\_\_\_\_  
 DEPTH IN SAND \_\_\_\_\_ PRODUCING SANDS AND THICKNESS OF EACH 5699-5712, 5673-77' & 5691-96'  
 PRODUCTION FIRST 24 HOURS \_\_\_\_\_ SETTLED PRODUCTION \_\_\_\_\_ STARTED PRODUCTION \_\_\_\_\_  
 DATE TUBED \_\_\_\_\_ SYPHON SET \_\_\_\_\_ SIZE \_\_\_\_\_ FEET \_\_\_\_\_

## CASING RECORD

SIZE	WEIGHT	PUT IN WELL		PULLED OUT		LEFT IN WELL		SHOES		PACKERS		
		FEET	IN.	FEET	IN.	FEET	IN.	LENGTH	MAKE	KIND	LENGTH	SET AT
13 3/8"	48#	640.64'				640.64'						
8 5/8"	24#	2630.16'				2630.16'						
5 1/2"	17 & 15.5#	5770'				5770'						

LINER: STATE SIZE AND WEIGHT \_\_\_\_\_ WHERE SET \_\_\_\_\_ FT. AND INS. \_\_\_\_\_  
 BLANK \_\_\_\_\_ FT. AND INS. \_\_\_\_\_  
 PERFORATED \_\_\_\_\_  
 HOW PUT TOGETHER \_\_\_\_\_ COUPLING \_\_\_\_\_ FLUSH-JOINT \_\_\_\_\_ INSERTED \_\_\_\_\_  
 REMARKS \_\_\_\_\_

## EQUIPMENT RECORD

TUBING				SUCKER RODS			PUMPING OUTFIT
SIZE	WEIGHT	FEET	IN.	FEET	IN.	SIZE AND KIND	DESCRIPTION, KIND, SIZE, ETC.

KIND OF SHOT \_\_\_\_\_ SIZE OF SHOT QUARTS \_\_\_\_\_ NUMBER OF SHOTS \_\_\_\_\_  
 NUMBER OF SHELLS \_\_\_\_\_ SIZE OF SHELLS \_\_\_\_\_ INCHES, DIAMETER \_\_\_\_\_  
 LENGTH OF SHELLS \_\_\_\_\_ FT. \_\_\_\_\_ INS. SHOT FURNISHED BY \_\_\_\_\_ TOP OF SHOT \_\_\_\_\_  
 BOTTOM OF SHOT \_\_\_\_\_ ANCHOR \_\_\_\_\_ WELL BRIDGED TO \_\_\_\_\_  
 PRODUCTION BEFORE SHOT \_\_\_\_\_ PRODUCTION AFTER SHOT \_\_\_\_\_  
 NAME OF SHOOTER \_\_\_\_\_ SHOT INSPECTED \_\_\_\_\_ BY \_\_\_\_\_  
 (COMPANY EMPLOYEE)  
 COMMENCED DRILLING DEEPER \_\_\_\_\_ COMPLETED DRILLING DEEPER \_\_\_\_\_

TOTAL DEPTH \_\_\_\_\_ PRODUCTION FIRST 24 HOURS \_\_\_\_\_ SETTLED PRODUCTION \_\_\_\_\_  
 REMARKS: Acidized With 15,000 Gallons Acid Thru Perforations 5699-5712', 5673-77',  
5691-96'. Test By Bailer Showed 5 G.O.P.H. & 10 G.S.W. Cable Tools Moved  
Off & Well Shut In.

RECEIVED  
 STATE CORPORATION COMMISSION  
 OCT 14 1953  
 REGISTRATION DIVISION  
 Wichita, Kansas

NOTE: IF WELL WAS DRY, STATE UNDER REMARKS, WHEN, HOW, AND BY WHOM PLUGGED. STATE UNDER REMARKS ANYTHING OF INTEREST NOT COVERED IN LOG. IF SPACE PROVIDED FOR REMARKS IS NOT SUFFICIENT WRITE ON BOTTOM OF LAST SHEET OF LOG.

