

STATE OF KANSAS
STATE CORPORATION COMMISSION

WELL PLUGGING RECORD

Give All Information Completely
Make Required Affidavit
Mail or Deliver Report to
Conservation Division
State Corporation Comm.
245 North Water
Wichita, KS 67202

Meade County, Sec. 17 Twp. 33S Rge. 30W E/W
Location as "NE/CNW $\frac{1}{4}$ SW $\frac{1}{4}$ " or footage from lines
220' W of SWSW

Lease Owner Pickrell Drilling Company
Lease Name Skinkle Trust A Well No. #1
Office Address 205 Litwin Bldg., Wichita, Kansas 67202
Character of Well (Completed as Oil, Gas or Dry Hole)
DRY HOLE

Date Well completed 2-27-80 19
Application for plugging filed 2-27-80 19
Application for plugging approved 2-27-80 19
Plugging commenced 2-27-80 19
Plugging completed 2-27-80 19


Reason for abandonment of well or producing formation
DRY HOLE

If a producing well is abandoned, date of last production
19

Was permission obtained from the Conservation Division or
its agents before plugging was commenced? YES

Name of Conservation Agent who supervised plugging of this well Duane L. Rankin
Producing formation _____ Depth to top _____ Bottom _____ Total Depth of Well 5700'

Show depth and thickness of all water, oil and gas formations.

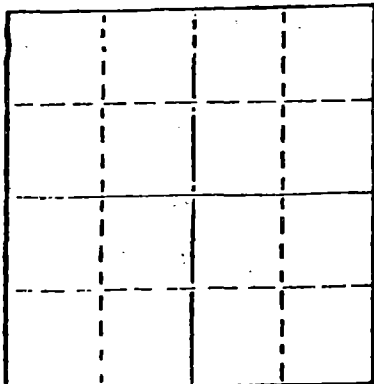

Locate well correctly on above
Section Plot

OIL, GAS OR WATER RECORDS

CASING RECORD

FORMATION	CONTENT	FROM	TO	SIZE	PUT IN	PULLED OUT
				8 5/8	700	None

Describe in detail the manner in which the well was plugged, indicating where the mud fluid was placed and the method or methods used in introducing it into the hold. If cement or other plugs were used, state the character of same and depth placed, from _____ feet to _____ feet for each plug set.

40 sacks at 1500'
20 sacks at 300'
10 sacks at 40' w/solid bridge plug
5 sacks in rathole Comp. 11:30 AM 2-27-80

(If additional description is necessary, use BACK of this sheet)

Name of Plugging Contractor Pickrell Drilling Company

STATE OF Kansas COUNTY OF Sedgwick, ss.
C.W. Sebitts (employee of owner) or (owner or operator)
of the above-described well, being first duly sworn on oath, says: That I have knowledge of the facts, statements, and matters herein contained and the log of the above-described well as filed and that the same are true and correct. So help me God.

(Signature) *C.W. Sebitts*
205 Litwin Building, Wichita, Kansas 67202
(Address)

SUBSCRIBED AND SWORN TO before me this 29 day of February, 19 80

My commission expires 2-18-84

Jo Ann Sarver Notary Public.



ROTARY DRILLING LOG

COMPANY: Pickrell Drilling Company & George Jones
205 Litwin Building
Wichita, Kansas 67202
LOCATION: Skinkle Trust 'A' #1
220' W of SWSW Sec. 17-33S-30W
Meade County, Kansas
CONTRACTOR: **PICKRELL DRILLING COMPANY**
Wichita, Kansas

Rotary Drilling Commenced 2-6-80
Rotary Drilling Completed 2-27-80

CASING RECORD: Spud date 2-6-80 Surf. pipe 8 5/8 set at 1520'KB w/700 sacks

LOG

(Figures indicate bottom of formation — measurements from top of rotary bushing.)

	200		
Clay and Sand	320	Lime and Shale	5212
Sand and Clay	560	Lime and Shale	5400
Red Bed	850	Lime and Shale	5430
	1523	Lime and Shale	5520
Shale	1950	Lime and Shale	5610
Shale and Lime	2250	Lime and Shale	5644
Lime and Shale	2345	TD	5700
Shale	2418		
Lime and Shale	2500		
Lime and Shale	2600		
Lime and Shale	2665		
Lime and Shale	2885		
Lime and Shale	3005		
Lime and Shale	3155		
Lime and Shale	3330		
Lime and Shale	3480		
Lime and Shale	3610		
Lime and Shale	3760		
Lime and Shale	3960		
Lime and Shale	3970		
Lime and Shale	4055		
Lime and Shale	4140		
Lime and Shale	4220		
Shale and Lime	4329		
Lime and Shale	4450		
Lime and Shale	4555		
Lime and Shale	4682		
Lime and Shale	4780		
Lime and Shale	4895		
Lime and Shale	5005		
Lime and Shale	5105		
Lime and Shale	5210		

RECEIVED
STATE COMMISSION
MAY 5 1980

The undersigned, C.W. Sebitts, Attorney-in-Fact for PICKRELL DRILLING COMPANY, hereby certifies in behalf of said Company, that the above is a true and correct log of the formation encountered in drilling the above well as reflected by the Daily Drilling Reports.

PICKRELL DRILLING COMPANY
By [Signature]
Attorney-in-Fact
C.W. Sebitts

STATE OF KANSAS }
COUNTY OF SEDGWICK } ss.:

On this 29 day of February, 19 80, before me the undersigned, a Notary Public, in and for

the County and State aforesaid, personally appeared C.W. Sebitts, to me known to be the identical person who subscribed the name of PICKRELL DRILLING COMPANY to the foregoing instrument as its Attorney-in-Fact and acknowledged to me that he executed the same as his free and voluntary act and deed, and as the free and voluntary act and deed of such company, for the uses and purposes therein set forth.

Given under my hand and seal of office the day and year last above written.

My commission expires: 2-18-84

[Signature]
Jo Ann Sarver Notary Public

