


WELL PLUGGING RECORD

Give All Information Completely
Make Required Affidavit
Mail or Deliver Report to:
Conservation Division
State Corporation Commission
211 No. Broadway
Wichita, Kansas

MEADE County. Sec. 17 Twp. 33S Rge. 30W (E) (W)
Location as "NE/CNWxSWx" or footage from lines SE/4 SW/4 SE/4
Lease Owner DAVIDOR & DAVIDOR, INC.
Lease Name BURMEISTER Well No. 1
Office Address 4515 N. SANTA FE, OKLAHOMA CITY, OKLA.
Character of Well (completed as Oil, Gas or Dry Hole) DRY HOLE
Date well completed 5/18/64 19
Application for plugging filed MAY 18 19 64
Application for plugging approved MAY 18 19 64
Plugging commenced MAY 18 19 64
Plugging completed MAY 18 19 64
Reason for abandonment of well or producing formation DRY HOLE

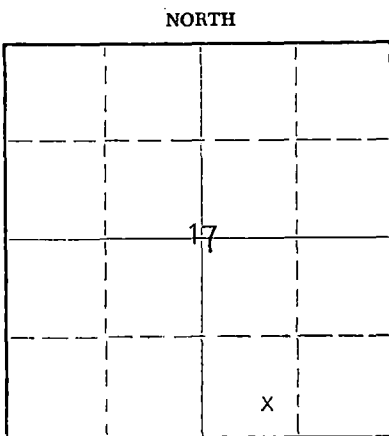

Locate well correctly on above
Section Plat

If a producing well is abandoned, date of last production 19
Was permission obtained from the Conservation Division or its agents before plugging was commenced? YES

Name of Conservation Agent who supervised plugging of this well HUGH SCOTT, ULYSSES, KANSAS
Producing formation _____ Depth to top _____ Bottom _____ Total Depth of Well 5750 Feet
Show depth and thickness of all water, oil and gas formations.

OIL, GAS OR WATER RECORDS

CASING RECORD

FORMATION	CONTENT	FROM	TO	SIZE	PUT IN	PULLED OUT
				8-5/8"	1476'	NONE

Describe in detail the manner in which the well was plugged, indicating where the mud fluid was placed and the method or methods used in introducing it into the hole. If cement or other plugs were used, state the character of same and depth placed, from _____ feet to _____ feet for each plug set.

HOLE FILLED WITH HEAVY MUD, 35-SACK CEMENT PLUG IN SURFACE CASING FROM 700' TO 823' AND 15-SACK CEMENT PLUG FROM THE SURFACE TO 45'.
WORK PERFORMED BY SUN CEMENTING COMPANY, LIBERAL, KANSAS.
JOB COMPLETED AT 8:00 A.M. ON MAY 18, 1964.

RECEIVED
STATE CORPORATION COMMISSION

MAY 20 1964

CONSERVATION DIVISION
Wichita, Kansas

(If additional description is necessary, use BACK of this sheet)
Name of Plugging Contractor SUN CEMENTING COMPANY
Address LIBERAL, KANSAS

STATE OF OKLAHOMA, COUNTY OF OKLAHOMA, ss.
HAROLD DAVIDOR (employee of owner) or (owner or operator) of the above-described well, being first duly sworn on oath, says: That I have knowledge of the facts, statements, and matters herein contained and the log of the above-described well as filed and that the same are true and correct. So help me God.

(Signature) Harold Davidor
4515 N. SANTA FE, OKLAHOMA CITY, OKLA.
(Address)

SUBSCRIBED AND SWORN TO before me this 19TH day of MAY, 19 64

My commission expires JULY 31, 1964 Notary Public.

ROTARY WELL LOG

RECEIVED
STATE CORPORATION COMMISSION

MAY 25 1964

CONSERVATION DIVISION
Wichita, Kansas

Davidor & Davidor, Inc. #1 Burmeister
SE SW SE Section 17-33S-30W
Meado County, Kansas

Commenced: 4/28/64
Completed: 5/17/64
Total Depth: 5750 ft. (Kelly bushing measurements)
Contractor: Patton Drilling Company, Inc.
Surface Pipe: 8-5/8" @ 117 1/2 ft. W/1100 sq.
Production Casing: None, D & A

Measurements are from Kelly bushings.

Sub structure	0	to	10 feet
Shells			250
Shells & sand			570
Shale & sand			685
Red bed			815
Red bed & shells			1000
Anhydrite & sand			1200
Anhydrite & shale			1325
Anhydrite & red bed			1474
Anhydrite & shale			2246
Shale & lime shells			2475
Lime			2653
Lime & shale			2724
Lime, dolomite, shale & chalk streaks			2856
Lime			2944
Lime & shale W/chalk streaks			3020
Chalky lime & shale			3092
Lime & shale W/chalk			3368
Chalky lime & shale			3455
Lime & shale W/chalk			3526
Lime & shale			3655
Sand & shale			3720
Lime & shale			3740
Lime			3909
Shale & lime			4032
Lime & shale			4472
Lime			4540
Lime & shale			4740
Lime			4997
Lime & shale			5059
Lime			5075
Lime & shale			5380
Lime & sandy shale			5396
Lime & shale			5694
Sandy shale & lime			5726
Lime & shale			5750 Rotary total depth

STATE OF KANSAS, COUNTY OF SEDGWICK SS.

I, the undersigned, being duly sworn, on oath state that the above statement and log is a true and correct record and log of the well drilled at the location above described.

PATTON DRILLING COMPANY, INC.

BY Robert W. Patton
Robert W. Patton, President

Subscribed and sworn to before me this 21st day of May, 1964

Lorene Schornick
Lorene Schornick, Notary Public

My Commission Expires August 7, 1966

