


Give All Information Completely  
Make Required Affidavit  
Mail or Deliver Report to:  
Conservation Division  
State Corporation Commission  
211 No. Broadway  
Wichita, Kansas

WELL PLUGGING RECORD

Meade County, Sec. 26 Twp. 33S Rge. 30 (X) (W)

Location as "NE/CNW&SW" or footage from lines NW NE  
Lease Owner Cities Service Oil Company  
Lease Name Novinger (Novinger Unit) C-4924 Well No. 507  
Office Address P. O. Box 1098, Liberal, Kansas 67901  
Character of Well (completed as Oil, Gas or Dry Hole) Oil  
Date well completed June 23 1952  
Application for plugging filed March 5 1972  
Application for plugging approved March 6 1972  
Plugging commenced April 6 1972  
Plugging completed April 7 1972  
Reason for abandonment of well or producing formation Depleted

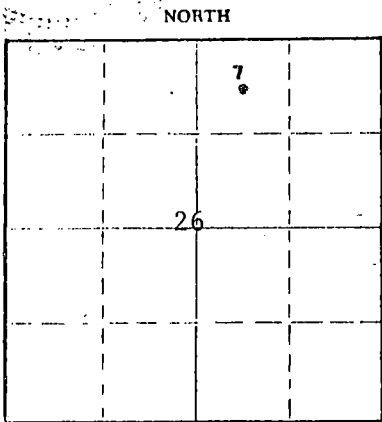

Locate well correctly on above  
Section Plat

If a producing well is abandoned, date of last production March 1961  
Was permission obtained from the Conservation Division or its agents before plugging was commenced? Yes

Name of Conservation Agent who supervised plugging of this well Ed Eves  
Producing formation Marmaton Depth to top 5294 Bottom 5301 Total Depth of Well 5950 Feet  
Show depth and thickness of all water, oil and gas formations.

OIL, GAS OR WATER RECORDS

CASING RECORD

FORMATION	CONTENT	FROM	TO	SIZE	PUT IN	PULLED OUT
Marmaton	Oil	5294'	5301'	13-3/8"	617'	0
				8-5/8"	2697'	0
				5-1/2"	5910'	3033'

Describe in detail the manner in which the well was plugged, indicating where the mud fluid was placed and the method or methods used in introducing it into the hole. If cement or other plugs were used, state the character of same and depth placed, from \_\_\_\_\_ feet to \_\_\_\_\_ feet for each plug set.

5100' to 5260' 20 sx cement plug  
2025' to 5100' Heavy mud  
1900' to 2025' 40 sx cement plug  
50' to 1900' Heavy mud  
0' to 50' 10 sx cement plug


RECEIVED  
STATE CORPORATION COMMISSION  
APR 11 1972  
CONSERVATION DIVISION  
Wichita, Kansas

(If additional description is necessary, use BACK of this sheet)  
Name of Plugging Contractor Toland and Johnston  
Address Box 94336, Oklahoma City, Oklahoma 73109

STATE OF KANSAS, COUNTY OF SEWARD, ss.  
R. L. Higginbottom (employee of owner) or (owner or operator) of the above-described well, being first duly sworn on oath, says: That I have knowledge of the facts, statements, and matters herein contained and the log of the above-described well as filed and that the same are true and correct. So help me God.

(Signature) R. L. Higginbottom  
Box 1098, Liberal, Kansas 67901  
(Address)

SUBSCRIBED AND SWORN to before me this 10th day of April, 1972

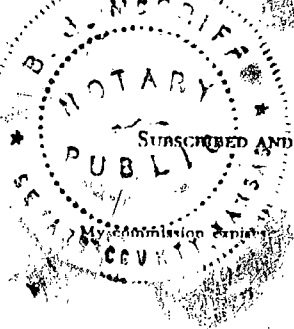

8-6-74

B. J. McGriff  
Notary Public.

**T. B. Henderson Well No. 7**  
**Wichita, Kansas**  
**Columbia Fuel Corporation**

Commenced: March 13, 1952  
 Completed: April 23, 1952

CASING RECORD


Set Top Clay	0	693
Shale & Limestone	693	900
Shale	900	1175
Lime	1175	1397
Shale & Lime	1397	1572
Lime	1572	1772
Lime & Shale	1772	1960
Sand & Lime	1960	2152
<b>TOTAL DEPTH</b>	<b>5710</b>	

STATE OF KANSAS )

CITY OF WICHITA )

Notarized

5-2-52

RECEIVED  
 STATE CORPORATION COMMISSION  
 MAR 3 1972  
 CONSERVATION DIVISION  
 Wichita, Kansas