

STATE OF KANSAS  
STATE CORPORATION COMMISSION

Give All Information Completely  
Make Required Affidavit  
Mail or Deliver Report to:  
Conservation Division  
State Corporation Commission  
211 No. Broadway  
Wichita, Kansas

WELL PLUGGING RECORD

Meade County, Sec 29 Twp. 33S Rge. 30W (E) (W)

Location as "NE/CNW/SW" or footage from lines C SW SE

Lease Owner Helmerich & Payne, Inc.

Lease Name BOND Well No. 1

Office Address Box 558, Garden City, Kansas

Character of Well (completed as Oil, Gas or Dry Hole) Dry Hole

Date well completed 18 December 1962 19

Application for plugging filed 18 December 1962 19

Application for plugging approved 18 December 1962 19


Plugging commenced 18 December 1962 19

Plugging completed 18 December 1962 19

Reason for abandonment of well or producing formation Dry Hole

If a producing well is abandoned, date of last production - 19

Was permission obtained from the Conservation Division or its agents before plugging was commenced? Yes

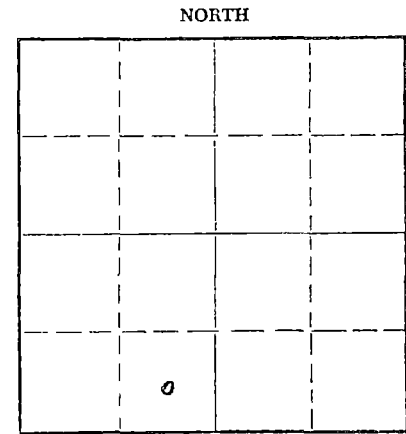

Locate well correctly on above Section Plat

Name of Conservation Agent who supervised plugging of this well Hugh E. Scott Liberal, Kansas

Producing formation - Depth to top - Bottom - Total Depth of Well 6075 Feet

Show depth and thickness of all water, oil and gas formations.

OIL, GAS OR WATER RECORDS

CASING RECORD

FORMATION	CONTENT	FROM	TO	SIZE	PUT IN	PULLED OUT
		0	1555	8-5/8"	1555	None

Describe in detail the manner in which the well was plugged, indicating where the mud fluid was placed and the method or methods used in introducing it into the hole. If cement or other plugs were used, state the character of same and depth placed, from feet to feet for each plug set.

6075 to 700 Heavy Rotary Mud  
700 to 595 Plug and 35 sacks pozmix cement  
595 to 45 Heavy Rotary Mud  
45 to 4 Wiper Plug and 15 sacks pozmix cement  
4 to 0 Cellar

Plugging completed at 4:00 PM, 18 December 1962

DEC 26 1962  
CONSERVATION DIVISION

(If additional description is necessary, use BACK of this sheet)

Name of Plugging Contractor Helmerich & Payne, Inc.

Address Utica at 21st., Tulsa, Okla.

STATE OF Kansas, COUNTY OF Finney, ss.

T. E. Mort (employee of owner) or (XXXXXX) of the above-described well, being first duly sworn on oath, says: That I have knowledge of the facts, statements, and matters herein contained and the log of the above-described well as filed and that the same are true and correct. So help me God.

(Signature) T.E. Mort

Box 558, Garden City, Kansas (Address)

SUBSCRIBED AND SWORN TO before me this 20 day of December, 1962

My commission expires July 1964 Robert N. Boyd Notary Public.

