


STATE OF KANSAS
STATE CORPORATION COMMISSION

Give All Information Completely
Make Required Affidavit
Mail or Deliver Report to:
Conservation Division
State Corporation Commission
211 No. Broadway
Wichita, Kansas

WELL PLUGGING RECORD

NORTH

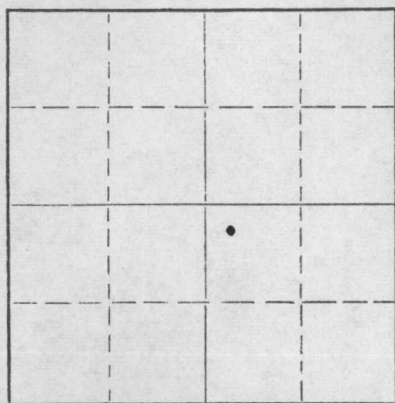

Locate well correctly on above
Section Plat

Meade County. Sec. 32 Twp. 33 Rge. (E) 30 (W)
Location as "NE/CNW/SW" or footage from lines Ctr NW/4 NW/4 SE/4
Lease Owner The Ohio Oil Company
Lease Name W. H. Bond "A" UN. Well No. 1
Office Address Liberal, Kansas
Character of Well (completed as Oil, Gas or Dry Hole) Oil
Date well completed August 19, 19 54
Application for plugging filed August 31, 19 57
Application for plugging approved September 3, 19 57
Plugging commenced September 17, 19 57
Plugging completed September 18, 19 57
Reason for abandonment of well or producing formation No Production

If a producing well is abandoned, date of last production February 19 19 55
Was permission obtained from the Conservation Division or its agents before plugging was commenced? Yes

Name of Conservation Agent who supervised plugging of this well M. A. Rives
Producing formation Atoka Depth to top 5619' Bottom 5631' Total Depth of Well 5990 Feet
Show depth and thickness of all water, oil and gas formations.

OIL, GAS OR WATER RECORDS

CASING RECORD

FORMATION	CONTENT	FROM	TO	SIZE	PUT IN	PULLED OUT
				13-3/8"	582'	None
				9-5/8"	2667'	602'
				5-1/2"	5862'	2763'

Describe in detail the manner in which the well was plugged, indicating where the mud fluid was placed and the method or methods used in introducing it into the hole. If cement or other plugs were used, state the character of same and depth placed, from _____ feet to _____ feet for each plug set.

Filled hole with sand from 5830' to 5765' and ran 5 sacks of cement to 5730'. Pulled 5 1/2" and 9-5/8" casing. Filled hole with heavy mud to 575', set a 10' rock bridge and ran 30 sacks of cement. Mudded the hole to 25', set 10' rock bridge and ran 15 sacks of cement to base of cellar.

(Monsanto Chemical Company is operator of the above described well.)

(If additional description is necessary, use BACK of this sheet)

Name of Plugging Contractor West Supply Co., Inc.
Address Chase, Kansas

STATE OF KANSAS, COUNTY OF PRATT, ss.

I, Bruce E. Roll, (employee of owner) or (owner or operator) of the above-described well, being first duly sworn on oath, says: That I have knowledge of the facts, statements, and matters herein contained and the log of the above-described well as filed and that the same are true and correct. So help me God.

(Signature) Bruce E. Roll
P. O. Box 580 Pratt, Kansas
(Address)

SUBSCRIBED AND SWORN TO before me this 23rd day of September, 19 57

My commission expires September 19, 1959

Notary Public.



SEP 24 1957

CONSERVATION DIVISION
Wichita, Kansas

PLUGGING
FILE SEC 32 T. 33 R. 30W
BOOK PAGE 41 LINE 15