


STATE OF KANSAS  
STATE CORPORATION COMMISSION

WELL PLUGGING RECORD

Give All Information Completely  
Make Required Affidavit  
Mail or Deliver Report to:  
Conservation Division  
State Corporation Commission  
211 No. Broadway  
Wichita, Kansas

Seward County. Sec. 8 Twp. 33 Rge.      (E) 31 (W)  
Location as "NE/CNW $\frac{1}{4}$ SW $\frac{1}{4}$ " or footage from lines C-SW-NE  
Lease Owner Kansas-Nebraska Natural Gas Company, Inc.  
Lease Name McVey Well No. 1  
Office Address 300 N. St. Joseph, Hastings, Nebraska  
Character of Well (completed as Oil, Gas or Dry Hole) Dry Hole  
Date well completed 12-26 19 59  
Application for plugging filed 19       
Application for plugging approved 19       
Plugging commenced 12-26 19 59  
Plugging completed 6 p.m. - 12-26 19 59  
Reason for abandonment of well or producing formation Dry Hole

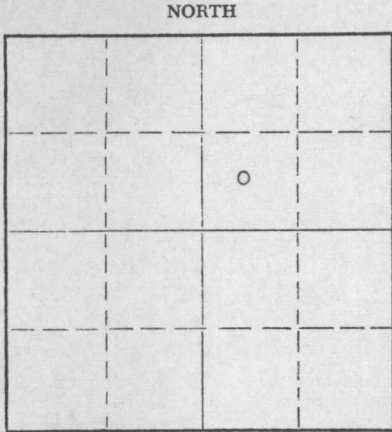

Locate well correctly on above  
Section Plat

If a producing well is abandoned, date of last production      19       
Was permission obtained from the Conservation Division or its agents before plugging was commenced? Yes

Name of Conservation Agent who supervised plugging of this well W. L. Lackamp, Jr.  
Producing formation      Depth to top      Bottom      Total Depth of Well 6058 Feet  
Show depth and thickness of all water, oil and gas formations.

OIL, GAS OR WATER RECORDS

CASING RECORD

FORMATION	CONTENT	FROM	TO	SIZE	PUT IN	PULLED OUT
		G. L.	552	13 3/8	552	none
		G. L.	2372	8 5/8	2372	683

Describe in detail the manner in which the well was plugged, indicating where the mud fluid was placed and the method or methods used in introducing it into the hole. If cement or other plugs were used, state the character of same and depth placed, from      feet to      feet for each plug set.

Shoved 13 3/8 casing plug ahead of drill pipe to 540.  
Plugged with 35 sacks of cement through drill pipe at 540.  
Top plug 15 sacks 25 feet to 5 feet.  
Hole was loaded with mud of 80 viscosity, weight 9.3 # per gallon,  
6 cc water loss.

RECEIVED  
STATE CORPORATION COMMISSION  
JAN 25 1960  
CONSERVATION DIVISION  
Wichita, Kansas

(If additional description is necessary, use BACK of this sheet)  
Name of Plugging Contractor Honaker-Davis  
Address Great Bend, Kansas

STATE OF Nebraska, COUNTY OF Adams, ss.  
S. D. Ford, Jr. (employee of owner) or (owner or operator) of the above-described well, being first duly sworn on oath, says: That I have knowledge of the facts, statements, and matters herein contained and the log of the above-described well as filed and that the same are true and correct. So help me God.

(Signature) [Signature] S. D. Ford, Jr.  
Hastings, Nebraska (Address)

SUBSCRIBED AND SWORN TO before me this 14th day of January, 1960

October 23, 1965

My commission expires     

RECEIVED  
STATE CORPORATION COMMISSION

J. ROLAND MILLER

Notary Public.

JAN 22 1960

DIVISION  
ansas

DRILLERS' LOG


McVey No. 1  
 Loc: SW NE  
 Sec: 8-338-31W  
 Seward County, Kansas  
 Company: Kansas-Nebraska Natural Gas Co., Inc.  
 Contractor: Honaker-Davis Drilg. Co.

Comm: 11-18-59  
 Comp: 12-26-59  
 Rotary Total Depth: 6055'  
 Casing: 13 3/8" at 552'  
 8 5/8" at 2372'  
 D & A

0	40	Top soil & sand	
40	495	Sand & clay	13 3/8" casing cemented at
495	715	Shale & shells	552' with 500 sacks posmix
715	800	Shale & Red Bed	and 2% calcium chloride.
800	888	Red Bed & Sand	
888	1405	Sand & Shale	
1405	1710	Shale & Shells	
1710	1800	Shale, Anhydrite, Shells	
1800	2062	Shale & Shells	
2062	2130	Shale & Lime	
2130	2200	Shale & Shells	8 5/8" casing cemented at
2200	2690	Shale & Lime	2372' with 400 sacks
2690	2815	Lime	cement and 2% calcium
2815	2910	Lime & Shale	chloride.
2910	2985	Shale & Lime	
2985	3809	Lime & Shale	
3809	3836	Lime	
3836	4460	Lime & Shale	
4460	4755	Lime	
4755	4825	Lime & Shale	
4825	4855	Lime	
4855	4970	Lime & Shale	
4970	5141	Lime	
5141	5190	Lime & Shale	
5190	5257	Lime	
5257	5300	Lime & Shale	
5300	5410	Lime	
5410	5444	Lime & Shale	
5444	5555	Lime	
5555	5615	Lime & Shale	
5615	5640	Lime	
5640	5775	Lime & Shale	
5775	5845	Shale & Lime	
5845	6055	Lime	
6055		Total Rotary Depth	D & A

**RECEIVED**  
 STATE CORPORATION COMMISSION  
 JAN 22 1960  
 CONSERVATION DIVISION  
 Wichita, Kansas

I certify that this is the true and correct copy of the  
 above log to the best of my knowledge.

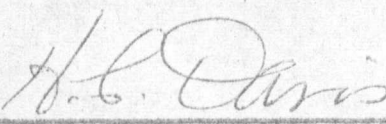  
 H. C. Davis

Subscribed and sworn to before me this 29th day  
 of December, 1959.