


STATE OF KANSAS
STATE CORPORATION COMMISSION

15-145-20876-0000
WELL PLUGGING RECORD

Give All Information Completely
Make Required Affidavit
Mail or Deliver Report to
Conservation Division
State Corporation Comm.
245 North Water
Wichita, KS 67202

Pawnee County. Sec. 27 Twp. 21 Rge. 15 E/W
Location as "NE/CNW $\frac{1}{4}$ SW $\frac{1}{4}$ " or footage from lines
SE SE SW

Lease Owner L.D. Davis
Lease Name Krueger Well No. 1
Office Address P. O. Box 324 Great Bend, Ks.
Character of Well (Completed as Oil, Gas or Dry Hole)
Dry hole

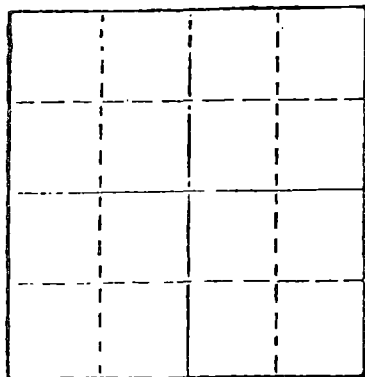

Locate well correctly on above
Section Plot

Date Well completed July 22 1981
Application for plugging filed July 22 1981
Application for plugging approved July 22 1981
Plugging commenced 10:15 A.M. July 22 1981
Plugging completed 11:15 A.M. July 22 1981
Reason for abandonment of well or producing formation

If a producing well is abandoned, date of last production
19

Was permission obtained from the Conservation Division or
its agents before plugging was commenced? yes

Name of Conservation Agent who supervised plugging of this well Marion Schmidt
Producing formation Depth to top Bottom Total Depth of Well 3910'
Show depth and thickness of all water, oil and gas formations.

OIL, GAS OR WATER RECORDS

CASING RECORD

FORMATION	CONTENT	FROM	TO	SIZE	PUT IN	PULLED OUT

Describe in detail the manner in which the well was plugged, indicating where the mud fluid was placed and the method or methods used in introducing it into the hold. If cement or other plugs were used, state the character of same and depth placed, from feet to feet for each plug set.

65 sx. at 680'
30 sx. at 240'
10 sx. at 40'
5 sx. in rat hole

RECEIVED
STATE CORPORATION COMMISSION
08-30-81
AUG 20 1981

(If additional description is necessary, use BACK of this sheet)
Name of Plugging Contractor Halliburton Conservation Division
Wichita, Kansas

STATE OF Kansas COUNTY OF Barton, ss.
Don Popp (employee of owner) or (owner or operator)


of the above-described well, being first duly sworn on oath, says: That I have knowledge of the facts, statements, and matters herein contained and the log of the above-described well as filed and that the same are true and correct. So help me Gdd.

(Signature) Don Popp
Hoisington, Kansas (Address)

SUBSCRIBED AND SWORN TO before me this 23rd day of July, 19 81

Bessie M. DeWerff
Bessie M. DeWerff Notary Public.

My commission expires 5-20-85

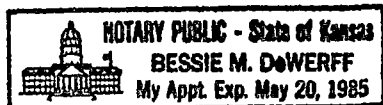

DRILLERS WELL LOG

L. D. DRILLING, INC. - CONTRACTOR L. D. DAVIS - OPERATOR

KRUEGER # 1
SE SE SW
Sec. 27-21S-SW
Pawnee County, Kansas

T.D. 3910'
Elev. 1977' K.B.

COMMENCED: 7-15-81
COMPLETED: 7-22-81

CASING

8 5/8" set at 651'

CEMENT:

W/350 sx. 50/50 Pozmix, 2% Gel, 3% CC

FORMATION

DEPTH

Sand	0 - 210
Shale	210 - 380
Sand	380 - 480
Red Bed	480 - 938
Anhy.	938 - 975
Shale & Shells	975 - 1380
Shale & Lime	1380 - 2310
Lime & Shale	2310 - 3910
R.T.D.	3910

FORMATION TOPS:

(LOG)

Heebner	3368
Toronto	3388
Douglas	3405
Brown Lime	3478
Lansing K/C	3486
Base K/C	3720
Marm. Lime	3733
Viola Chert	3816
Simpson Sand	3854
Simpson Shale	3885
Arb.	3909
Log T.D.	3911

AFFIDAVIT

STATE OF KANSAS)
COUNTY OF BARTON) ss

RECEIVED
STATE CORPORATION COMMISSION

AUG 20 1981

I certify that this is a true and correct copy of the above log to the best of my knowledge.

CONSERVATION DIVISION
Wichita, Kansas

L. D. DRILLING, INC.

Don Popp
Don Popp

Sworn to and subscribed before me this 4th day of August, 1981.

My appointment expires: 5-20-85 Bessie M. DeWerff
Bessie M. DeWerff, Notary Public

