


STATE OF KANSAS
STATE CORPORATION COMMISSION

WELL PLUGGING RECORD

Give All Information Completely
Make Required Affidavit
Mail or Deliver Report to:
Conservation Division
State Corporation Commission
800 Biting Building
Wichita, Kansas

Pratt County. Sec. 36 Twp. 27 Rge. 15 (E) W (W)

NORTH

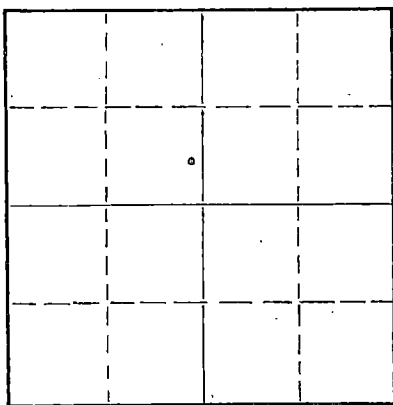

Locate well correctly on above
Section Plat

Location as "NE/CNW&SW&" or footage from lines SE SE SW
Lease Owner McKnab Drilling, Inc.
Lease Name Barnes Well No. 1
Office Address 1107 Union National Bldg. - Wichita, Kansas
Character of Well (completed as Oil, Gas or Dry Hole) Dry Hole
Date well completed June 6, 1956
Application for plugging filed June 6, 1956
Application for plugging approved June 6, 1956
Plugging commenced August 25, 1956
Plugging completed September 4, 1956
Reason for abandonment of well or producing formation Dry

If a producing well is abandoned, date of last production _____ 19____
Was permission obtained from the Conservation Division or its agents before plugging was commenced? yes

Name of Conservation Agent who supervised plugging of this well Merle Rives
Producing formation _____ Depth to top _____ Bottom _____ Total Depth of Well _____ Feet
Show depth and thickness of all water, oil and gas formations.

OIL, GAS OR WATER RECORDS

CASING RECORD

FORMATION	CONTENT	FROM	TO	SIZE	PUT IN	PULLED OUT
Cherokee Sand	4648'	0	4648	5-1/2"	5-5-56	Sept. 4, 1956
Red Bed	Surface	0	417	8-5/8"	4-10-56	

Describe in detail the manner in which the well was plugged, indicating where the mud fluid was placed and the method or methods used in introducing it into the hole. If cement or other plugs were used, state the character of same and depth placed, from _____ feet to _____ feet for each plug set.

Filled hole w/ water w/ pickup truck by Sun Oil Well Cementing Co. - Pump into Cherokee formation to kill gas @ 1700# pressure. Dumped 35 gal of sand in hole to fill up above perforations, then dumped 5 sacks of wet cement in dump bailer. Let cement set over night. Shot off pipe @ 3500'. Circulated oil & mud. Shot off @ 3133' - Pulled pipe up to 1700'. Circulated 30 sacks magogel & water. Mixed mud (3 bbl. water to 1 sack mud) Circulated good mud clear around. Finished pulling pipe. Set Howco plug @ 300' w/ rock. Dumped 20 sacks cement on plug. Filled w/ rock. Dumped 10 sacks cement on top plug to bottom of cellar.

(If additional description is necessary, use BACK of this sheet)

Name of Plugging Contractor Sun Cementing Co.
Address Great Bend, Kansas

STATE OF Kansas, COUNTY OF Bedgwick, ss.
Don Gardner (employee of owner) or (owner or operator) of the above-described well, being first duly sworn on oath, says: That I have knowledge of the facts, statements, and matters herein contained and the log of the above-described well as filed and that the same are true and correct. So help me God.

(Signature) Don Gardner
1107 Union National Bldg. - Wichita, Kansas
(Address)

SUBSCRIBED AND SWORN TO before me this 11th day of September, 1956

Charles E. Barlowe
Notary Public.

My commission expires July 28, 1958

PLUGGING
FILE SEC 36 27 R15W
BOOK PAGE 90 LINE 44

SEP 12 1956
09-12-56

COMPANY: McKnab Drilling, Inc.
503 Union National Bank Building
Wichita, Kansas

LOCATION: Barnes #1
SE SE SW 36-27-15
Pratt County, Kansas

CONTRACTOR: McKnab Drilling, Inc.
503 Union National Bank Building
Wichita, Kansas

CASING RECORD: 8-5/8" surface set @ 417' with 300 sacks cement
5-1/2" casing set @ 4647' with 150 sacks cement

DRILLER'S LOG

<u>FROM</u>	<u>TO</u>		
0	75	Surface Clay	COMMENCED: 5-15-56
75	245	Sand	COMPLETED: 6-9-56
245	275	Shale	
275	390	Sand	
390	855	Red Bed & Shale	
855	925	Shale & Shells	
925	950	Anhydrite	
950	1030	Shale & Shells	
1030	1125	Salt & Shells	
1125	1184	Shale	
1184	1545	Shale & Shells	
1545	1740	Shale	
1740	1780	Lime & Shale	
1780	1820	Shale & Lime	
1820	2035	Lime & Shale	
2035	2255	Lime	
2255	2400	Lime & Shale	
2400	2470	Shale & Lime	
2470	3057	Lime & Shale	
3057	3185	Shale & Lime	
3185	3245	Shale	
3245	3300	Lime & Shale	
3300	3360	Lime	
3360	3450	Shale & Lime	
3450	3505	Lime & Shale	
3505	3605	Lime	
3605	4005	Lime & Shale	
4005	4385	Lime	
4385	4415	Lime & Shale	
4415	4480	Lime	
4480	4493	Shale	
4493	4505	Chert & Lime	
4505	4525	Chert & Shale	
4525	4531	Shale	
4531	4545	Lime & Chert	
4545	4548	Chert	
4548	4576	Chert & Sand	
4576	4588	Chert & Shale	
4588	4605	Shale	
4605	4635	Shale & Chert	
4635	4654	Chert & Lime	
4654	4660	Chert, Lime & Shale	
4660	4725	Shale & Sand	
4725	4738	Shale & Lime	
4738	4780	Lime (Arbuckle)	
	4780	Rotary Total Depth	

PLUGGING
FILE SEC. 36 T. 27 R. 15W
BOOK PAGE 90 LINE 44

RECEIVED
MAY 17 1956
WICHITA, KANSAS

The undersigned, Don Gardner, Secretary-Treasurer of McKnab Drilling, Inc., hereby certifies in behalf of said company, that the above log is a true and correct log of the formation encountered in drilling the above well as reflected by the daily drilling reports.

McKNAB DRILLING, INC.

By: 

Don Gardner

Subscribed and sworn to before me this 27th day of June, 1956.



Notary Public

My commission expires: July 28, 1958

PLUGGING
FILE SEC 36T 27 R 15W
BOOK PAGE 90 LINE 44