


STATE OF KANSAS
STATE CORPORATION COMMISSION

WELL PLUGGING RECORD

Give All Information Completely
Make Required Affidavit
Mail or Deliver Report to:
Conservation Division
State Corporation Commission
211 No. Broadway
Wichita, Kansas

T 28S NORTH R 13W

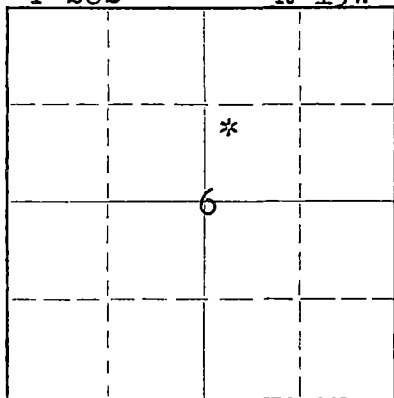

Locate well correctly on above
Section Plat

Pratt County. Sec. 6 Twp. 28S Rge. 13W (E) (W)
Location as "NE/CNW/SW" or footage from lines NW SW NE
Lease Owner R. W. Rine Drilling Company
Lease Name Mowbray Well No. 1
Office Address 320 Central Building - Wichita, Kansas
Character of Well (completed as Oil, Gas or Dry Hole) _____
Date well completed _____ 19____
Application for plugging filed _____ 19____
Application for plugging approved _____ 19____
Plugging commenced September 6 19 56
Plugging completed September 8 19 56
Reason for abandonment of well or producing formation _____

If a producing well is abandoned, date of last production _____ 19____
Was permission obtained from the Conservation Division or its agents before plugging was commenced? Yes

Name of Conservation Agent who supervised plugging of this well Merle Rives
Producing formation _____ Depth to top _____ Bottom _____ Total Depth of Well 4529 Feet
Show depth and thickness of all water, oil and gas formations.

OIL, GAS OR WATER RECORDS

CASING RECORD

FORMATION	CONTENT	FROM	TO	SIZE	PUT IN	PULLED OUT
				8-5/8"	847'	None
				5-1/2"	4528'	3302'
				Hole was plugged back to 4158' and casing was perforated from 3838' to 3840'.		

Describe in detail the manner in which the well was plugged, indicating where the mud fluid was placed and the method or methods used in introducing it into the hole. If cement or other plugs were used, state the character of same and depth placed, from _____ feet to _____ feet for each plug set.

Filled the hole with sand from 4158' to 3830' and ran 5 sacks of cement. Cement filled to 3795'. Pumped in 30 sacks of jell mud and 100 sacks of cement to plug the hole to the base of the cellar. Plugging completed.

(If additional description is necessary, use BACK of this sheet)
Name of Plugging Contractor West Supply Co., Inc.
Address Chase, Kansas

STATE OF KANSAS, COUNTY OF SEDGWICK, ss.
E. H. SLOYER (employee of owner) or (owner or operator) of the above-described well, being first duly sworn on oath, says: That I have knowledge of the facts, statements, and matters herein contained and the log of the above-described well as filed and that the same are true and correct. So help me God.

(Signature) E. H. Sloyer
420 Union Center, Wichita, Kansas
(Address)

SUBSCRIBED AND SWORN TO before me this 3rd day of October, 1956

My commission expires July 9, 1960

Edna Landry Notary Public.

PLUGGING
FILE SEC. 6 T. 28 R. 13W
BOOK PAGE 23 LINE 23

RECEIVED
STATE CORPORATION COMMISSION
OCT 4 1956
CONSERVATION DIVISION
Wichita, Kansas

STERLING DRILLING CO.

STERLING, KANSAS

September 27, 1955

WELL LOG ----- Mowbray # 1

Location: NW SW NE, Section 6-28-13W,
Pratt County, Kansas

OWNER: R. W. Rine Drilling Company
ROTARY DRILLING CONTRACTOR: Sterling Drilling Company

LOG DATED: 9-27-55 (w.r.)
COMPLETED: 9-28-55 (w.r.)

TOTAL DEPTH: 4520'

LOG

0-290	Sand and Shale
290-730	Sand, Shale and Red Bed
730-830	Red Bed
830-845	Anhydrite
845-1755	Shale and Shells
1755-1850	Shale
1850-1920	Limestone
1920-2045	Shale and Limestone
2045-2275	Limestone
2275-2700	Shale and Limestone
2700-2875	Shale
2875-3000	Limestone and Shale
3000-3085	Limestone
3085-3225	Shale and Limestone
3225-3530	Limestone
3530-3745	Shale and Limestone
3745-3815	Shale
3815-4100	Limestone
4100-4140	Simson Sand
4140-4435	Sand and Shale
4435-4513	Shale and Limestone
4513-4526	Arbuckle Limestone

CASING LOG

Run 27 joints of 5 1/8" casing
set at 3815' with 500 sacks bulk
cement.

Set 5 1/2" casing at 4520' with
250 sacks cement.

RECEIVED
STATE CORPORATION COMMISSION

AUG 28 1955

CONSERVATION DIVISION
Wichita, Kansas

PLUGGING

FILE SEC. 6 T. 28 R. 13W
BOOK PAGE 93 LINE 22