


WELL PLUGGING RECORD

Give All Information Completely
Make Required Affidavit
Mail or Deliver Report to:
Conservation Division
State Corporation Commission
211 No. Broadway
Wichita, Kansas

Pratt County, Sec. 6 Twp. 28 Rge. 13 (E)X (W)

Location as "NE/CNW/SW" or footage from lines C-NE NW NE
Lease Owner H. C. Bennett
Lease Name Fannie Well No. A-3
Office Address 1212 Union National Bank Bldg., Wichita, Kansas
Character of Well (completed as Oil, Gas or Dry Hole) oil well
Date well completed 6-5-57 19
Application for plugging filed 6-1-65 19
Application for plugging approved 6-3-65 19
Plugging commenced 6-26-65 19
Plugging completed 6-26-65 19
Reason for abandonment of well or producing formation depleted

NORTH

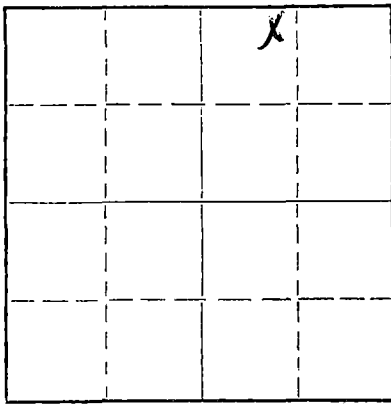

Locate well correctly on above
Section Plat

If a producing well is abandoned, date of last production 19
Was permission obtained from the Conservation Division or its agents before plugging was commenced? yes

Name of Conservation Agent who supervised plugging of this well Archie Elving
Producing formation Depth to top Bottom Total Depth of Well 4506 Feet
Show depth and thickness of all water, oil and gas formations.

OIL, GAS OR WATER RECORDS

CASING RECORD

FORMATION	CONTENT	FROM	TO	SIZE	PUT IN	PULLED OUT
				9 5/8	469	none
				7	4500	3604.44

Describe in detail the manner in which the well was plugged, indicating where the mud fluid was placed and the method or methods used in introducing it into the hole. If cement or other plugs were used, state the character of same and depth placed, from feet to feet for each plug set.

Set 50' rock bridge from 4040' to 3990' and dump 5 sacks cement.
Set 10' rock bridge from 270' to 260', mixed and dumped 4 sacks cement. Let cement set up. Bailed hole dry to bridge at 260' and dumped 24 sacks cement. Mud hole to 40', set 10' rock bridge from 40' to 20' and dump 12 sacks cement.

RECEIVED
STATE CORPORATION COMMISSION

JUL 12 1965

CONSERVATION DIVISION
Wichita, Kansas

(If additional description is necessary, use BACK of this sheet)
Name of Plugging Contractor Flint Engineering & Construction Company
Address Box 950, El Dorado, Kansas

STATE OF KANSAS, COUNTY OF BUTLER, ss.

(employee of owner) or (owner or operator) of the above-described well, being first duly sworn on oath, says: That I have knowledge of the facts, statements, and matters herein contained and the log of the above-described well as filed and that the same are true and correct. So help me God.

(Signature) Laura Bawdle

El Dorado, Kansas
(Address)

SUBSCRIBED AND SWORN TO before me this 7th day of July, 1965

Ronald P. Harman

Notary Public.

My commission expires 9-27-67

WELL LOG BUREAU—KANSAS GEOLOGICAL SOCIETY
508 East Murdock, - Wichita, Kansas


Company- PHILLIPS PETRO. CO.
Farm- Fannie "A" No. 3

SEC. 6 T. 28 R. 13W
NE NW NE

Total Depth. 4506' PB 4471'
Comm 4-21-57 Comp. 6-5-57
Shot or Treated.
Contractor.
Issued. 8-10-57

County Pratt

KANSAS

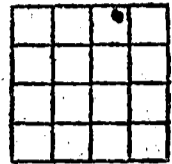

Elevation. 1899' DF

Production. I. P. 106 BO & 86 BWPD

CASING:
9 5/8" 469' w/300 sx cem.
7" 4501' w/75 sx cem.

Figures indicate Bottom of Formations.

soil-clay	40
sand	180
red bed-shale	355
shale-shells-red bed	470
shale-shells	640
shale	675
shale-shells	890
Anhydrite	930
shale-shells	1350
lime-shale	1890
lime	2390
lime-shale	2605
lime	2695
lime-shale	3040
lime	3115
lime-shale	3405
lime	3470
lime-shale	3635
lime	3700
shale	3735
lime-shale	3805
lime	3945
lime-chert	3995
lime	4060
lime-chert	4085
lime	4167
lime-shale	4185
lime-shale-chert	4235
lime	4305
lime-chert	4325
lime	4395
lime-sand	4440
sand-shale	4489
lime-shale	4498
lime	4506

Total Depth PB 4471

TOPS: Scout	
Anhydrite	890
Ft. Riley	1905
Topeka	3286

TOPS: (Hallibutron log)	
Heebner	3634
Toronto	3654
Douglas	3663
Brown limestone	3798
Lansing-Kansas City	3810
Drum	3979
B/Kansas City	4162
Marmaton	4187
Mississippian	4264
Viola	4316
Simpson shale	4375
Simpson sand	4383
Arbuckle	4495

Pay: Simpson sand 4383
Perf. 4386-4394
Acid Frac: 10,000 gals.

RECEIVED
STATE CORPORATION COMMISSION

JUL 12 1955

CONSERVATION DIVISION
Wichita, Kansas