


Give Information Completely
Make Required Affidavit
Mail or Deliver Report to
Conservation Division
State Corporation Commission
211 No. Broadway
Wichita, Kansas

NORTH

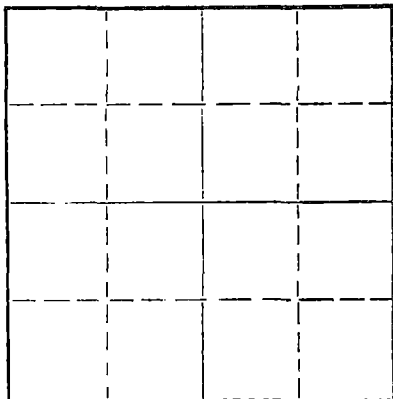

Locate well correctly on above
Section Plat

Harper County, Sec. 24 Twp. 31S Rge. 9W (E) (W)

Location as "NE/CNW/SW" or footage from lines N 1/2 NE NE
Lease Owner Wilkinson Drlg. Co. Inc.
Lease Name Darnes Well No. 1
Office Address West 10th Great Bend, Kansas
Character of Well (completed as Oil, Gas or Dry Hole) _____
Date well completed _____ 19____
Application for plugging filed _____ 19____
Application for plugging approved _____ 19____
Plugging commenced 9/29/61 _____ 19____
Plugging completed 10/1/61 _____ 19____
Reason for abandonment of well or producing formation _____
If a producing well is abandoned, date of last production _____ 19____
Was permission obtained from the Conservation Division or its agents before plugging was commenced? _____

Name of Conservation Agent who supervised plugging of this well Fred W. Hampel
Producing formation _____ Depth to top _____ Bottom _____ Total Depth of Well _____ Feet
Show depth and thickness of all water, oil and gas formations.

OIL, GAS OR WATER RECORDS

CASING RECORD

FORMATION	CONTENT	FROM	TO	SIZE	PUT IN	PULLED OUT

Describe in detail the manner in which the well was plugged, indicating where the mud fluid was placed and the method or methods used in introducing it into the hole. If cement or other plugs were used, state the character of same and depth placed, from _____ feet to _____ feet for each plug set.
Plugged back to 4360 ft. with sand and dumped 5 sacks cement.
Set rock bridge at 225 ft. dumped 20 sacks cement mudded hole
to 35 ft. dumped 10 sacks of cement.

RECEIVED
STATE CORPORATION COMMISSION
OCT 24 1961
CONSERVATION DIVISION
Wichita, Kansas

(If additional description is necessary, use BACK of this sheet)
Name of Plugging Contractor Central Pipe Pulling Co.
Address 1416 Coolidge, Great Bend, Kansas

STATE OF KANSAS, COUNTY OF SEDGWICK, ss.
Walter M. Wilkinson (employee of owner) or (owner or operator) of the above-described well, being first duly sworn on oath, says: That I have knowledge of the facts, statements, and matters herein contained and the log of the above-described well as filed and that the same are true and correct. So help me God.

(Signature) Walter M. Wilkinson
805 Union Center, Wichita 2, Kansas
(Address)

SUBSCRIBED AND SWORN TO before me this 23rd day of October, 19 61

My commission expires January 2, 1965
Carolyn K. Iverson
Carolyn K. Iverson Notary Public.

WILKINSON DRILLING INCORPORATED

1111 UNION NATIONAL BUILDING
WICHITA 2, KANSAS

15-077-16092-0000

DARNES #1

Company - Wilkinson Drlg., Inc.
Contractor - Co. Tools
Commenced - 1-17-57
Completed - 2- 2-57

Location: N/2 NE NE, Section 24-31S-9W,
Harper County, Kansas
Elevation: 1610 DF
Casing: 256' - 8 5/8" Cemented W/250 Sks.

FIGURES INDICATE BOTTOMS OF FORMATION:

Depth	Formation
0 - 525	Red Beds & Shale
525 - 725	Red Beds & Shells
725 - 1353	Shale & Shells
1353 - 1400	Anhydrite
1400 - 1555	Rough Shells
1555 - 2005	Lime & Shale
2005 - 2100	Lime
2100 - 2700	Lime & Shale
2700 - 2790	Lime
2790 - 3075	Lime & Shale
3075 - 3205	Shale & Lime
3205 - 3620	Lime & Shale
3620 - 4305	Lime
4305 - 4359	Lime & Shale
4359 - 4430	Chert
4430 - 4450	Lime & Shale
4450 - T.D.	

RECEIVED
STATE CORPORATION COMMISSION
FEB 14 1963
CONSERVATION DIVISION
Wichita, Kansas

We hereby certify the above and foregoing to be a true and correct copy of the Log on the #1 Darnes, located in the N/2 NE NE, Section 24-31S-9W, Harper County, Kansas.

WILKINSON DRILLING, INC.

Walter M. Wilkinson
Walter M. Wilkinson

Subscribed and sworn to before me this 8th day of February, 1957.

Josephine M. Brown
Notary Public

My commission expires: November 8, 1960.

