

WELL PLUGGING RECORD

15-077-30192-0000

Give All Information Completely
Make Required Affidavit
Mail or Deliver Report to:
Conservation Division
State Corporation Commission
211 No. Broadway
Wichita, Kansas

Harper County, Sec. 24 Twp. 31S Rge. 9 (W)

Location as "NE/CNW/SW" or footage from lines Ctr. NE/4 NE/4

Lease Owner Messman-Rinehart Oil Company

Lease Name Darnes-Ison "C" Well No. 1

Office Address 1432 Wichita Plaza Bldg., Wichita 2, Kansas

Character of Well (completed as Oil, Gas or Dry Hole) Dry Hole

Date well completed December 15 19 63

Application for plugging filed December 15 19 63


Application for plugging approved December 15 19 63

Plugging commenced December 15 19 63

Plugging completed December 15 19 63

Reason for abandonment of well or producing formation Dry

NORTH

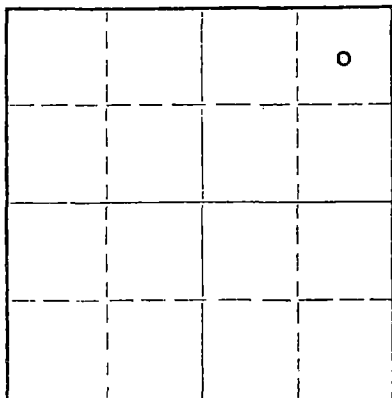

Locate well correctly on above Section Plat

If a producing well is abandoned, date of last production 19

Was permission obtained from the Conservation Division or its agents before plugging was commenced? yes

Name of Conservation Agent who supervised plugging of this well A. Elving, Box 248, Pratt, Kansas

Producing formation Depth to top Bottom Total Depth of Well 2965 Feet

Show depth and thickness of all water, oil and gas formations.

OIL, GAS OR WATER RECORDS

CASING RECORD

FORMATION	CONTENT	FROM	TO	SIZE	PUT IN	PULLED OUT
				10-3/4"	189'	none

Describe in detail the manner in which the well was plugged, indicating where the mud fluid was placed and the method or methods used in introducing it into the hole. If cement or other plugs were used, state the character of same and depth placed, from feet to feet for each plug set.

Set bottom plug at 210 ft. with 1/4 sk. hulls and 2 sx. cement. Set top plug at 40 ft. with 1/4 sk. hulls and 8 sx. cement. 2 sx. cement in rat hole.

RECEIVED
STATE CORPORATION COMMISSION

JAN 7 1964

CONSERVATION DIVISION
Wichita, Kansas

(If additional description is necessary, use BACK of this sheet)

Name of Plugging Contractor Messman-Rinehart Oil Company

Address 1432 Wichita plaza Bldg., Wichita 2, Kansas

STATE OF Kansas, COUNTY OF Sedgwick, ss.

J. A. Gilliland

(employee of owner) of the above-described

well, being first duly sworn on oath, says: That I have knowledge of the facts, statements, and matters herein contained and the log of the above-described well as filed and that the same are true and correct. So help me God.

(Signature) *J. A. Gilliland*

1432 Wichita Plaza Bldg., Wichita 2, Kansas
(Address)

SUBSCRIBED AND SWORN TO before me this 6th day of January 1964

My commission expires December 1, 1964

Barbara J. Scott, Notary Public.

15-077-30192-0000

NO. 1 DARNES-ISON "C"

Well Record:

Location:	Ctr. NE/4 NE/4 Section 24-31S-9W Harper County, Kansas	Commenced:	December 7, 1963
Operator:	Messman-Rinehart Oil Company 1432 Wichita Plaza Bldg. Wichita 2, Kansas	Completed:	December 15, 1963
Contractor:	Messman-Rinehart Oil Company 1432 Wichita Plaza Bldg. Wichita 2, Kansas	Elevation:	1592' K/B
		Production:	D & A

Casing Record: 10-3/4" @ 189' w/150 sx. cement

*** L O G ***

Sand and Clay	40
Red Bed & Gyp	189
Red Bed & Shells	540
Red Bed	650
Shale & Shells	1300
Shale & Shells - Lime	1400
Lime & Shale	1514
Shale & Lime	1568
Lime & Shale	1735
Shale & Lime (Chalky)	1830
Shale	1915
Lime & Shale	1985
Shale & Lime	2075
Lime & Shale	2620
Lime	2700
Lime & Shale	2965 R.T.D.

Sample Tops:

1556'	- Top Chase Group (-36)
1630'	- Winfield Lime (-38)
1824'	- Base Fort Riley (-232)
2340'	- Indian Cave Sand (-748)
2490'	- Tarkio Zone (-898)
2806'	- Howard Lime (-1214)
2917'	- Topeka Lime (-1325)

The undersigned, MESSMAN-RINEHART OIL COMPANY, hereby certifies that the above log is a true and correct log of the formation encountered in drilling the above well as reflected by the Daily Drilling Reports.

MESSMAN-RINEHART OIL COMPANY

By: _____

J. A. Gilliland
J. A. Gilliland

Subscribed and sworn to before me
this 6th day of January, 1964.

Barbara J. Scott
Barbara J. Scott, Notary Public

My Commission Expires: December 1, 1964