


STATE OF KANSAS
STATE CORPORATION COMMISSION

Give All Information Completely
Make Required Affidavit
Mail or Deliver Report to:
Conservation Division
State Corporation Commission
211 No. Broadway
Wichita, Kansas

WELL PLUGGING RECORD

15-077-00044-0000

NORTH

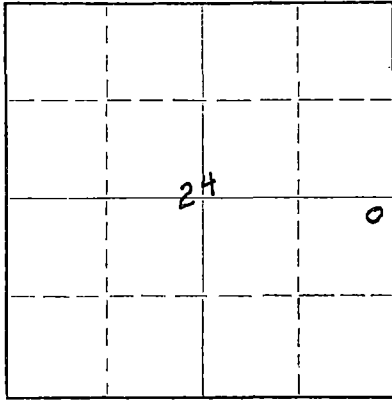

Locate well correctly on above
Section Plat

Harper County. Sec. 24 Twp. 31 Rge. (E) 9 (W)
Location as "NE/CNW/SW" or footage from lines NE/NE/SE
Lease Owner S. A. Berwick Drilling Company
Lease Name Darns Well No. 1-B
Office Address P. O. Box 64, Great Bend, Kansas
Character of Well (completed as Oil, Gas or Dry Hole)
Date well completed 3-22-1955
Application for plugging filed 4-10-1956
Application for plugging approved 4-12-1956
Plugging commenced 4-15-56 19
Plugging completed 4-21-56 19
Reason for abandonment of well or producing formation

If a producing well is abandoned, date of last production 19
Was permission obtained from the Conservation Division or its agents before plugging was commenced? yes

Name of Conservation Agent who supervised plugging of this well M. A. Rives
Producing formation Depth to top Bottom Total Depth of Well 4379 Feet
Show depth and thickness of all water, oil and gas formations.

OIL, GAS OR WATER RECORDS

CASING RECORD

FORMATION	CONTENT	FROM	TO	SIZE	PUT IN	PULLED OUT
				8-5/8"	117'	None
				5-1/2"	4500'	3733.67

Describe in detail the manner in which the well was plugged, indicating where the mud fluid was placed and the method or methods used in introducing it into the hole. If cement or other plugs were used, state the character of same and depth placed, from feet to feet for each plug set.

Plugging started 4-15-56 and completed 4-21-56. Measured in to T. D. 4379'. Plugged off bottom with 35' of sand. Shot casing off at 3733.67' and pulled pipe out of hole. Filled hole with heavy mud to 250'. Set permanent rock bridge and dumped in 15 sacks of cement. Filled hole with heavy mud. Built permanent rock bridge at 117' and dumped in 10 sacks of cement. Filled hole with heavy mud. Capped well with 10 sacks of cement.

(If additional description is necessary, use BACK of this sheet)

Name of Plugging Contractor J. O. Forbes, d/b/a/ Forbes Casing Pulling Company
Address Box 221, Great Bend, Kansas

STATE OF Kansas, COUNTY OF Barton, ss.
J. O. Forbes (employee of owner) or (owner or operator) of the above-described well, being first duly sworn on oath, says: That I have knowledge of the facts, statements, and matters herein contained and the log of the above-described well as filed and that the same are true and correct. So help me God.

(Signature) J. O. Forbes
Great Bend Kansas (Address)

SUBSCRIBED AND SWORN TO before me this 23 day of April, 1956

My commission expires April 8, 1957
Notary Public.

STATE CORP. BOOK

MAY 21 1956

CONSERVATION DIVISION
Wichita, Kansas

PLUGGING
FILE SEC 24 T 31 R 9W
BOOK PAGE 53 LINE 3

Darnes - B1

Total Depth: 4500'

Commenced R.D. : 3-8-55

Completed R.D. : 3-22-55

NE-NE-SE Sec. 24 -31- 9

Harper County, Kansas

Elevation: 1571 DF

Initial Prod. :

Contractor: S.A. Berwick

Drilling Company

15-077-0004-0000

Strata	Depth
Sand	0- 20
Red Rock	20- 160
Red Bed & Shale	160- 215
Red Bed	215- 580
Shale & Shells	580- 1115
Anhydrite	1115- 1150
Shale & Shells	1150- 1575
Lime & Shale	1575- 1775
Shale	1775- 2300
Shale & Lime	2300- 3220
Lime	3220- 3690
Lime & Shale	3690- 3910
Lime	3910- 3995
Lime & Chat	3995- 4384
Lime	4384- 4500

I hereby certify the above a true and correct log of said well as reflected by the daily drilling report.


S.A. Berwick Drilling Company

By: _____
S.A. Berwick Owner

Signed and sworn to in my presence this -- day of May, 1955, by S.A. Berwick owner of the S.A. Berwick Drilling Company.

Notary Public

My Commission Expires: April 11, 1959

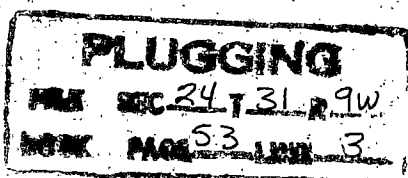

APR 12 1955
OCCUPATION DIVISION
WICHITA, KANSAS