


Give All Information Completely
Make Required Affidavit
Mail or Deliver Report to:
Conservation Division
State Corporation Commission
211 No. Broadway
Wichita, Kansas

15-077-01011-0000

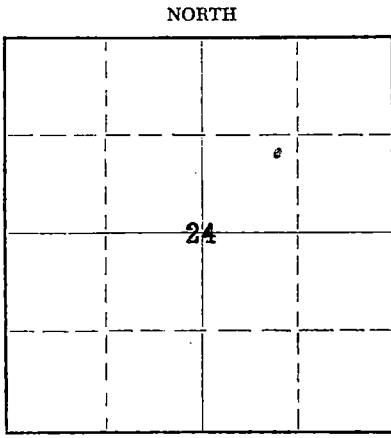

Locate well correctly on above Section Plat

Barber County. Sec. 24 Twp. 31 Rge. 9 (E) W (W)
Location as "NE/CNW/SW" or footage from lines NE SW NE
Lease Owner Parker Petroleum Co., Inc.
Lease Name Darnes B Well No. 4
Office Address Box 791, Ponca City, Okla.
Character of Well (completed as Oil, Gas or Dry Hole) oil
Date well completed Aug. 27 19 56
Application for plugging filed June 14 19 61
Application for plugging approved _____ 19 _____
Plugging commenced July 15 19 61
Plugging completed July 20 19 61
Reason for abandonment of well or producing formation uneconomical to continue to produce

If a producing well is abandoned, date of last production July 19 58
Was permission obtained from the Conservation Division or its agents before plugging was commenced? Yes

Name of Conservation Agent who supervised plugging of this well Fred W. Hampel
Producing formation Mississippi chert Depth to top 4382 Bottom 4486 Total Depth of Well 4486 Feet
Show depth and thickness of all water, oil and gas formations.

OIL, GAS OR WATER RECORDS

CASING RECORD

FORMATION	CONTENT	FROM	TO	SIZE	PUT IN	PULLED OUT
Mississippi chert	oil & water	4374	4380	8-5/8"	277	none
				4 1/2"	4486	none

Describe in detail the manner in which the well was plugged, indicating where the mud fluid was placed and the method or methods used in introducing it into the hole. If cement or other plugs were used, state the character of same and depth placed, from 2520 feet to 2320 feet for each plug set.

Dumped pea gravel and cement on bottom to plug.
Took up slack and work tension in casing. Shot loose at 2520'.
Well flowed salt water and gas. Controlled well and pumped in cement to kill flow.
Filled casing with mud and capped with welded on steel plate 3' feet below ground level.
Filled cellar

RECEIVED
STATE CORPORATION COMMISSION
MAR 27 1962
CONSERVATION DIVISION
WICHITA, KANSAS

(If additional description is necessary, use BACK of this sheet)
Name of Plugging Contractor Smith and Smith Casing Pulling Co.
Address Cushing, Okla.

STATE OF Oklahoma, COUNTY OF Kay, ss.
James G. Heid (employee of owner) or (owner or operator) of the above-described well, being first duly sworn on oath, says: That I have knowledge of the facts, statements, and matters herein contained and the log of the above-described well as filed and that the same are true and correct. So help me God.

(Signature) James G. Heid
Box 791, Ponca City, Okla. (Address)

SUBSCRIBED AND SWORN TO before me this 26 day of March, 1962, 19 62

My commission expires 12/1/63
Frances Fern Alston Notary Public.

WELL LOG BUREAU—KANSAS GEOLOGICAL SOCIETY
508 East Murdock, Wichita, Kansas

COPY


15-077-01011-0000

Company: O.H. PARKER
Farm: Darnes "B" No. 4

SEC. 24 T. 31 R. 9W
NE SW NE

Total Depth. 4486'
Comm. 7-2-56 Comp. 7-17-56
Shot or Treated.
Contractor. Gabbert-Jones Drilg. Co.
Issued. 11-10-56

County Harper
KANSAS

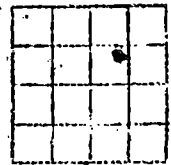

CASING:
8 5/8" 272' w/225 sx cem.
4 1/2" 4486' w/100 sx cem.

Elevation. 1578'

Production. 30 BOPD

Figures indicate Bottom of Formations.

sand-clay	80
red bed-shells	127
shale-shells-red bed	272
shale-shells	300
shale-shells-red bed	1030
shale-shells	1335
Anhydrite-shale	1375
lime-shale	1530
lime	1905
lime-shale	2415
shale-lime-shells	2605
shale-lime	3000
brkn lime-shale	3120
sdv lime-shale	3160
lime	3190
brkn lime	3350
brkn lime-shale	3467
lime-shale	3550
lime-sdv shale	3590
lime	4180
lime-shale	4382
Mississippi chert	4486
Total Depth	

TOPS: Scout	
Heebner	3424
Lansing	3614
Mississippi	4372

RECEIVED
STATE CORPORATION COMMISSION
MAY 3 1962
CONSERVATION DIVISION
Wichita, Kansas