


STATE OF KANSAS  
STATE CORPORATION COMMISSION

15-677-6096B-0000 Form CP-4

WELL PLUGGING RECORD

Give All Information Completely  
Make Required Affidavit  
Mail or Deliver Report to:  
Conservation Division  
State Corporation Commission  
P. O. Box 17027  
Wichita, Kansas 67217  
NORTH

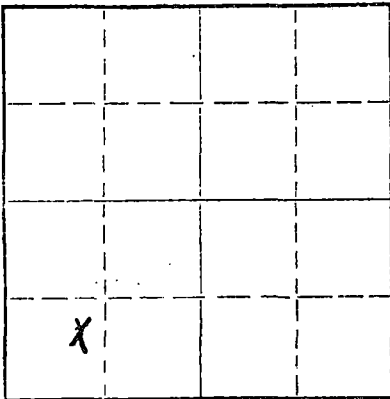

Locate well correctly on above Section Plat

Harper County. Sec. 24 Twp. 31 Rge. 9 (E)W (W)  
Location as "NE/CNW&SW&" or footage from lines NW/4 SW/4 SW/4  
Lease Owner Pickrell Drilling Co.  
Lease Name Darnes 'A' Well No. # 3  
Office Address 705 Fourth Nat'l Bank Bldg. ; Wichita, Ks. 67202  
Character of Well (completed as Oil; Gas or Dry Hole) Oil  
Date well completed January 4 1956  
Application for plugging filed August 21 1972  
Application for plugging approved August 22 1972  
Plugging commenced August 19 1972  
Plugging completed August 23 1972  
Reason for abandonment of well or producing formation Well Depleted

If a producing well is abandoned, date of last production August 18 1972  
Was permission obtained from the Conservation Division or its agents before plugging was commenced? Yes

Name of Conservation Agent who supervised plugging of this well Russell Biberstein  
Producing formation Mississippian Depth to top 4365 Bottom 4382 Total Depth of Well 4462 Feet  
Show depth and thickness of all water, oil and gas formations.

OIL, GAS OR WATER RECORDS

CASING RECORD

FORMATION	CONTENT	FROM	TO	SIZE	PUT IN	PULLED OUT
				8 5/8"	295	None
				5 1/2"	4458	3614

Describe in detail the manner in which the well was plugged, indicating where the mud fluid was placed and the method or methods used in introducing it into the hole. If cement or other plugs were used, state the character of same and depth placed, from \_\_\_\_\_ feet to \_\_\_\_\_ feet for each plug set.

August 19, 1972 Plugged off bottom. Dumped sand to 4350'. Mixed and dumped 5 sx of cement.  
August 23, 1972 Plugged off top. Set 10' rock bridge at 290'. Filled 8 5/8" surface casing from 290' to base of cellar with 3000 lb. P.S.I. ready-mix concrete.


RECEIVED  
STATE CORPORATION COMMISSION  
SEP 19 1972  
CONSERVATION DIVISION  
Wichita, Kansas

(If additional description is necessary, use BACK of this sheet)  
Name of Plugging Contractor RISS CASING PULLING, INC.  
Address P. O. Box 1082 ; Great Bend, Kansas 67530

STATE OF Kansas, COUNTY OF Sedgwick, ss. Dale M. Robinson

(employee of owner) or (owner or operator) of the above-described well, being first duly sworn on oath, says: That I have knowledge of the facts, statements, and matters herein contained and the log of the above-described well as filed and that the same are true and correct. So help me God.

(Signature) Dale M. Robinson  
705 Fourth National Bank Bldg, Wichita, Kansas  
(Address)

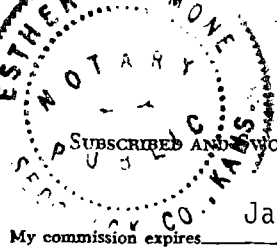

SUBSCRIBED AND SWORN TO before me this 18th day of September, 1972  
January 19, 1973  
My commission expires  
Esther Lamone Notary Public.

GABBERT-JONES DRILLING COMPANY  
WICHITA, KANSAS  
DRILLERS WELL LOG

DARNES #3  
 NW SW SW SECTION 24-31-9W  
 HARPER COUNTY, KANSAS  
 COMMENCED 11-21-55  
 COMPLETED 12-7-55

15-077-00948-0600

DEPTH		FORMATION	REMARKS
FROM	TO		
0	40	SAND	RAN 298' OF 8 5/8" CASING CEMENTED @ 295' W/225 SACKS CEMENT.
40	295	RED BED, SAND & SHALE	
295	310	RED BED	RAN 4469' OF 5 1/2" CASING CEMENTED @ 4459' W/150 SACKS CEMENT.
310	815	RED BED & SHALE	
815	1050	SHALE	
1050	1100	SALT	
1100	1345	SHALE & SHELLS	
1345	1510	ANHYDRITE & SHALE	
1510	1615	LIME	
1615	1830	LIME & SHALE	
1830	2037	LIME	
2037	2490	LIME & SHALE	
2490	2600	SHALE & SHELLS	
2600	2820	SHALE & LIME	
2820	3155	LIME	
3155	3545	LIME & SHALE	
3545	3555	LIME	
3555	3613	SAND	
3613	3920	LIME	
3920	3934	SHALE & LIME	
3934	4382	LIME	
4382	4462	CHERT & LIME	
4462	TD		

**RECEIVED**  
 STATE CORPORATION COMMISSION  
 AUG 22 1972  
 CONSERVATION DIVISION  
 Wichita, Kansas

I, E. E. HALL CERTIFY THIS TO BE A TRUE AND CORRECT COPY OF THE DRILLER'S WELL LOG FOR THE WELL DESCRIBED ABOVE.

E. E. Hall

STATE OF KANSAS )  
 )  
 COUNTY OF SEDGWICK ) SS

BEFORE ME, THE UNDERSIGNED, A NOTARY PUBLIC, WITHIN AND FOR SAID COUNTY AND STATE, ON THIS 14<sup>th</sup> DAY OF December, 1955, PERSONALLY APPEARED E. E. Hall TO ME PERSONALLY KNOWN TO BE THE IDENTICAL PERSON WHO EXECUTED THE WITHIN AND FOREGOING INSTRUMENT AND ACKNOWLEDGED TO ME THAT HE EXECUTED THE SAME AS HIS FREE AND VOLUNTARY ACT AND DEED FOR THE USES AND PURPOSES THEREIN SET FORTH.

IN WITNESS WHEREOF, I HAVE HEREUNTO SET MY HAND AND OFFICIAL SEAL THE DAY AND YEAR LAST ABOVE WRITTEN.

MY COMMISSION EXPIRES 10/29/56

Barbara Oldfield  
 NOTARY PUBLIC