


AFFIDAVIT OF COMPLETION FORM

ACO-1

This form shall be filed in triplicate with the Kansas Corporation Commission, 200 Colorado Derby Building, Wichita, Kansas 67202, within ten days after the completion of the well, regardless of how the well was completed. Circle one: Oil, gas, dry, SWD, OWWO, injection. Type and complete ALL sections. Applications must be filed for dual completion, commingling, salt water disposal and injection. Attach wireline logs (i.e. electrical log, sonic log, gamma ray neutron log, etc.) KCC#-(316)263-3238.

OPERATOR Rine Drilling Company
 ADDRESS Suite 600, 300 W. Douglas
Wichita, Kansas 67202
 **CONTACT PERSON Donna K. McKee
 PHONE 1-316-276-1333
 PURCHASER Inland Crude Purchasing Corp.
 ADDRESS 200 Douglas Bldg.
Wichita, KS 67202
 DRILLING CONTRACTOR Rine Drilling Company
 ADDRESS Suite 600, 300 W. Douglas
Wichita, Kansas 67202
 PLUGGING N/A
 CONTRACTOR ADDRESS _____

API NO. 15-025, -20,564 -00-00
 COUNTY Clark
 FIELD Snake Creek
 PROD. FORMATION Toronto
 LEASE Barby
 WELL NO. 6-21
 WELL LOCATION NE SE SE
990 Ft. from East Line and
990 Ft. from South Line of
 the SE/4 SEC. 21 TWP 34S RGE 21W

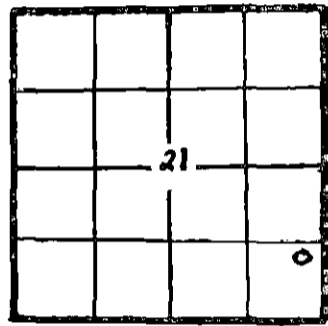

WELL PLAT
 KCC
 KGS
 MISC _____
 (Office Use)

TOTAL DEPTH 4,420' PBTD _____
 SPUD DATE 1/14/82 DATE COMPLETED 1/26/82
 ELEV: GR 1769' DF 1781' KB 1782'

DRILLED WITH (~~S&B~~) (ROTARY) (~~AT~~) TOOLS (New) / (~~Used~~) casing.
CASING RECORD

Report of all strings set — surface, intermediate, production, etc.

Purpose of string	Size hole drilled	Size casing set (in O.D.)	Weight lbs/ft.	Setting depth	Type cement	Sacks	Type and percent additives
Conductor	30"	20"	24#	95'	Class "H"	350	2% Calcel
Surface	12 1/4"	8 5/8"	24#	843'	Common Lite	100 400	3%cc 2% gel 3% CACL 1/2#FC 1/2#Calcel
Production	7 7/8"	4 1/2"	15.5#	4,420'	Common	175	18% salt, 3/4% C.F.R.

LINER RECORD			PERFORATION RECORD		
Top, ft.	Bottom, ft.	Sacks cement	Shots per ft.	Size & type	Depth Interval
N/A			2 SPF	Jumbo	4,282-4,292'

ACID, FRACTURE, SHOT, CEMENTATION RECORD

Amount and kind of material used	Depth interval treated
1000 gal. 15% de-mud.	4,282-4,292'
500 gal. MSA 10%	4,282-4,292'

Date of first production 4/8/82 Producing method (flowing, pumping, gas lift, etc.) pumping Gravity 400
 RATE OF PRODUCTION PER 24 HOURS
 Oil 190 bbls. Gas none MCF Water no % Gas-oil ratio N/A CFPB
 Disposition of gas (vented, used on lease or sold) _____ Perforations 4,282-4,292'

**The person who can be reached by phone regarding any questions concerning this information. A witnessed initial test by the Commission is required if the well produces more than 25 BOPD or is located in a Basic Order Pool.

STATE RECEIVED
 APR 2 1982
 CONSERVATION DIVISION
 Wichita, Kansas

TO
 110

Name of lowest fresh water producing stratum Sand & Gravel Depth 225'
 Estimated height of cement behind Surface Pipe 3.614
 DV USED? no

WELL LOG

Formation Description, Contents, etc.	Top	Bottom	Name	Depth
D.S.T. #1 4266-90 30-60-60-90, strong blow G.T.S. in 25 min. GA 60 MCF thru out 2nd flow. Rec. approx. 3000' of hvy. gas cut mdy oil. IFP 58-135 FFP 135-212 ISIP 964 FSIP 964	4,078 4,134 4,221 4,255 4,279 4,314	4,080 4,136 4,224 4,257 4,281 4,317	B./Lecompton Elgin Sand Oread Heebner Toronto Douglas	-2298 -2354 -2442 -2475 -2499 -2535
D.S.T. #2 4290-4314 30-30-30-30. No. blow. Rec. 90' of mud. charts. Show of v. sl. plugging IFP 116-116 FFP 116-116 ISIP 714 FSIP 232				
D.S.T. #3 4311-48' 30-30-30-30. No. blow. Rec. 10' of mud. IFP 19-19 FFP 19-19 ISIP 930 FSIP 691				


A F F I D A V I T

STATE OF KANSAS, COUNTY OF SEDGWICK SS, _____

E. J. RINE OF LAWFUL AGE, BEING FIRST DULY SWORN UPON HIS OATH,
 DEPOSES THAT HE IS PRESIDENT (~~EXEC~~) (OF) RINE DRILLING COMPANY
 OPERATOR OF THE BARBY LEASE, AND IS DULY AUTHORIZED TO MAKE
 THIS AFFIDAVIT FOR AND ON THE BEHALF OF SAID OPERATOR, THAT WELL NO. 6-21 ON
 SAID LEASE HAS BEEN COMPLETED AS OF THE 26th DAY OF January, 1982, AND THAT
 ALL INFORMATION ENTERED HEREIN WITH RESPECT TO SAID WELL IS TRUE AND CORRECT.
 FURTHER AFFIANT SAITH NOT.

(S) E. J. Rine
 E. J. Rine, President

SUBSCRIBED AND SWORN BEFORE ME THIS 20th DAY OF April 19 82

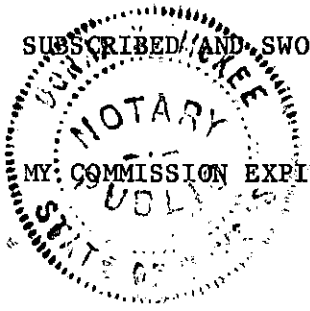

Donna K. McKee
 NOTARY PUBLIC
 Donna K. McKee, Notary Public



APR 21 1982
 CONSERVATION DIVISION
 Wichita Kansas