


15-191-00057-00-00

STATE OF KANSAS
STATE CORPORATION COMMISSION

WELL PLUGGING RECORD

Give All Information Completely
Make Required Affidavit
Mail or Deliver Report to:
Conservation Division
State Corporation Commission
212 North Market, Insurance Bldg.
Wichita, Kansas

Sumner County. Sec. 18 Twp. 34 Rge. 2 (E) W (W)
Location as "NE/CNW/SW" or footage from lines NE NW SE
Lease Owner Pickrell Drilling Company
Lease Name Fuhrmann Well No. #1
Office Address 705 Fourth National Bank Building, Wichita 2, Kansas
Character of Well (completed as Oil, Gas or Dry Hole) Dry
Date well completed 5-18-60 19 60
Application for plugging filed 5-17- 19 60
Application for plugging approved same 19
Plugging commenced same 19
Plugging completed 5-18- 19 60
Reason for abandonment of well or producing formation Dry

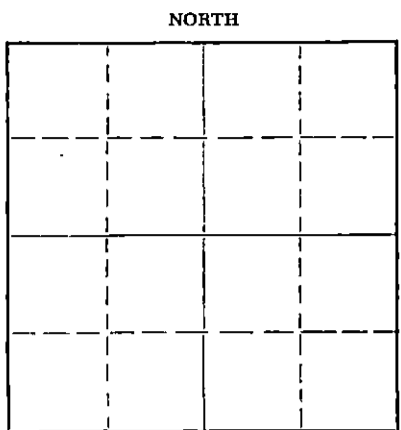

Locate well correctly on above
Section Plat

If a producing well is abandoned, date of last production _____ 19____
Was permission obtained from the Conservation Division or its agents before plugging was commenced? yes

Name of Conservation Agent who supervised plugging of this well Lee N. Guthrie
Producing formation _____ Depth to top _____ Bottom _____ Total Depth of Well 4642 Feet
Show depth and thickness of all water, oil and gas formations.

OIL, GAS OR WATER RECORDS

CASING RECORD

FORMATION	CONTENT	FROM	TO	SIZE	PUT IN	PULLED OUT
				8-5/8"	280'	None

Describe in detail the manner in which the well was plugged, indicating where the mud fluid was placed and the method or methods used in introducing it into the hole. If cement or other plugs were used, state the character of same and depth placed, from _____ feet to _____ feet for each plug set.

Globe Oil Well and Cementing used pump truck, heavy mud to 260' set bridge with 30 sacks cement. Set bridge at 65', cemented with 65 sacks. Two sacks of cement to plug rat hole.

RECEIVED
STATE CORPORATION COMMISSION
MAY 26 1960
CONSERVATION DIVISION
Wichita, Kansas

(If additional description is necessary, use BACK of this sheet)
Name of Plugging Contractor Pickrell Drilling Company
Address 705 Fourth National Bank Building, Wichita 2, Kansas

STATE OF KANSAS, COUNTY OF Sedgwick, ss.
Carl W. Sebitts (owner or operator) of the above-described well, being first duly sworn on oath, says: That I have knowledge of the facts, statements and matters herein contained and the log of the above-described well as filed and that the same are true and correct. So help me God.

(Signature) [Signature]
705 Fourth National Bank Building, Wichita, Kan.
(Address)

SUBSCRIBED AND SWORN TO before me this 25th day of May, 1960

My commission expires September 24, 1962
Maxine Johnson Notary Public.

ROTARY DRILLING LOG

15-191-00057-00-00

COMPANY: Pickrell Drilling Company
705 Fourth National Bank Building
Wichita 2, Kansas

Rotary Drilling Commenced 4-29-60
Rotary Drilling Completed 5-18-60

LOCATION: NE NW SE, Section 18-34-2W
Sumner County, Kansas
Fuhrmann #1

CONTRACTOR: **PICKRELL DRILLING COMPANY**
Wichita, Kansas

CASING RECORD: 280' (7 jts.) 8-5/8" Armco spiral weld casing. Set @ 283', cemented with 180 sacks of cement. Cement circulated. Completed 3:45 A.M. 4-29-60.

Dry and Abandoned

LOG

(Figures indicate bottom of formation — measurements from top of rotary bushing.)

Circ. for samples:

15	Sand	3617'
185	Shale and Sand	4163'
280	Sandy, Shale, Limy, Gyp	4179'
500	Blue Shale	4195'
620	Shale, salt, gyp, anhydrite	4526'
800	Lime and Shale	4574'
3186	Sandy Lime and Shale	4582'
3252	Lime and Shale	4587'
3552	Lime	4592'
3617-?	Cleveland Sand	4597'
3704	Lime and Shale	4602'
4179	Lime and Shale (Miss. @ 4155)	4607'
4266	Lime	4611'
4290	Mississippian	4616'
4312	Miss. Lime	4620'
4334	Lime	4625'
4358	Miss. (Lime)	4630'
4407	Lime	4642'
4434	Mississippi (Lime)	
4505	Lime	
4520	Miss. (Dolomite, Lime and Shale)	
4574	Lime and Shale	500 0°
4588	Shale and Dolomite	1500 0°
4597	Lime (Viola)	
4611	Sand (Simpson)	S.L.M.
4642	Rotary Total Depth	2000' OK

Slope Tests:

500 0°
1500 0°

S.L.M.

2000' OK
3000" OK
4000' OK

RECEIVED
STATE CORPORATION COMMISSION

MAY 26 1960

CONSERVATION DIVISION
Wichita, Kansas

The undersigned, C. W. Sebitts, Attorney-in-Fact for PICKRELL DRILLING COMPANY, hereby certifies in behalf of said Company, that the above is a true and correct log of the formation encountered in drilling the above well as reflected by the Daily Drilling Reports.

PICKRELL DRILLING COMPANY

By C. W. Sebitts
C. W. Sebitts, Partner

STATE OF KANSAS }
COUNTY OF SEDGWICK } ss.:

On this 25th day of May, 1960, before me the undersigned, a Notary Public, in and for

the County and State aforesaid, personally appeared C. W. Sebitts, to me known to be the identical person who subscribed the name of PICKRELL DRILLING COMPANY to the foregoing instrument as its Attorney-in-Fact and acknowledged to me that he executed the same as his free and voluntary act and deed, and as the free and voluntary act and deed of such company, for the uses and purposes therein set forth.

Given under my hand and seal of office the day and year last above written.

My commission expires: September 24, 1962

Maxine Johnson
Notary Public
Maxine Johnson