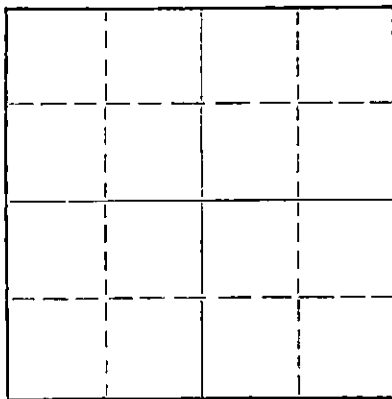


Give All Information Completely
Make Required Affidavit
Mail or Deliver Report to:
Conservation Division
State Corporation Commission
212 No. Market
Wichita, Kansas

WELL PLUGGING RECORD

NORTH

Locate well correctly on above
Section Plat

Sumner

County. Sec. 21 Twp. 34S Rge. 2 (W)

Location as "NE/CNW/SW" or footage from lines. SE/4 SE/4 NE/4

Lease Owner Jones & Pellow Oil Company

Lease Name Delbert Johnson

Well No. One (1)

Office Address 101 Northeast 26th Street, Oklahoma City, Oklahoma 73105

Character of Well (completed as Oil, Gas or Dry Hole) Dry Hole

Date well completed September 1, 1967

19

Application for plugging filed September 1 (In Field)

19 67

Application for plugging approved September 1 (In Field)

19 67

Plugging commenced September 1

19 67

Plugging completed September 1

19 67

Reason for abandonment of well or producing formation Dry Hole

If a producing well is abandoned, date of last production 19

Was permission obtained from the Conservation Division or its agents before plugging was commenced? Yes

Name of Conservation Agent who supervised plugging of this well

Producing formation Depth to top Bottom Total Depth of Well 4571 Feet

Show depth and thickness of all water, oil and gas formations.

OIL, GAS OR WATER RECORDS

CASING RECORD

FORMATION	CONTENT	FROM	TO	SIZE	PUT IN	PULLED OUT
		0	280'	8-5/8"		

Describe in detail the manner in which the well was plugged, indicating where the mud fluid was placed and the method or methods used in introducing it into the hole. If cement or other plugs were used, state the character of same and depth placed, from feet to feet for each plug set.

Ran in 300' 4-1/2" Pipe open ended and push plug to 300'.

Set 30 sacks; plug set 8 Sacks plug at 40' - Cement came up to top of surface - plugged Rathole W/2 sacks - Jet Pits

RECEIVED
STATE CORPORATION COMMISSION

DEC 12 1967

CONSERVATION DIVISION
Wichita, Kansas

(If additional description is necessary, use BACK of this sheet)

Name of Plugging Contractor Indian Drilling Company

Address Petroleum Building, Tulsa, Oklahoma

STATE OF OKLAHOMA, COUNTY OF TULSA, ss.

John H. Burgher (employee of owner) or (owner or operator) of the above-described well, being first duly sworn on oath, says: That I have knowledge of the facts, statements, and matters herein contained and the log of the above-described well as filed and that the same are true and correct. So help me God. INDIAN DRILLING COMPANY

(Signature)

Petroleum Building, Tulsa, Oklahoma 74103
(Address)

SUBSCRIBED AND SWORN TO before me this 8th day of December, 1967

My commission expires February 21, 1969

Maxine D. Provine

Notary Public.