


P.

Give All Information Completely
Make Required Affidavit
Mail or Deliver Report to:
Conservation Division
State Corporation Commission
211 No. Broadway
Wichita, Kansas

WELL PLUGGING RECORD

NORTH

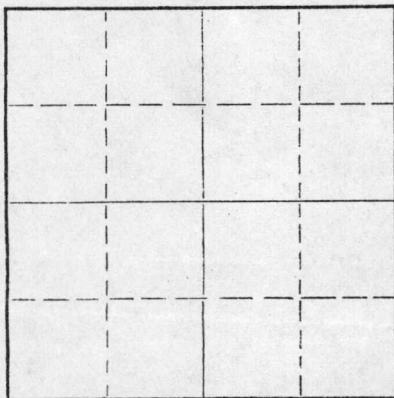

Locate well correctly on above
Section Plat

Sumner County, Sec. 22 Twp 34 S Rge. 2 W (E) (W)
Location as "NE/CNW/SW" or footage from lines SW NW NE
Lease Owner Herndon Drilling Co.
Lease Name Johnson Well No. A 1.
Office Address P.O. Box 489, Tulsa, Okla.
Character of Well (completed as Oil, Gas or Dry Hole) Dry hole.
Date well completed 4-30 19 60
Application for plugging filed 7-17 19 61
Application for plugging approved 7-17 19 61
Plugging commenced 7-18 19 61
Plugging completed 7-22 19 61
Reason for abandonment of well or producing formation Dry hole

If a producing well is abandoned, date of last production 19
Was permission obtained from the Conservation Division or its agents before plugging was commenced? Yes

Name of Conservation Agent who supervised plugging of this well Gene Graham
Producing formation Mississippi chat Depth to top Bottom Total Depth of Well 4585' Feet
Show depth and thickness of all water, oil and gas formations.

OIL, GAS OR WATER RECORDS

CASING RECORD

FORMATION	CONTENT	FROM	TO	SIZE	PUT IN	PULLED OUT

Describe in detail the manner in which the well was plugged, indicating where the mud fluid was placed and the method or methods used in introducing it into the hole. If cement or other plugs were used, state the character of same and depth placed, from feet to feet for each plug set.

Filled up W/gravel from 4179' to 4090' dump 5 sacks cement over perf. Filled W/mud to 240' of ground level. Set plug & dump 10' rock bridge thru 5 1/2" casing, dump 20 sacks cement thru casing, fill up W/mud to 30' of surface, set 10' rock bridge dump 5 sacks cement.

(Shot pipe at 3940 in cement. Shot pipe at 3402' & pulled same).

RECEIVED
STATE CORPORATION COMMISSION
SEP 7 1961
CONSERVATION DIVISION
Wichita, Kansas

(If additional description is necessary, use BACK of this sheet)
Name of Plugging Contractor Red Top Drilling Co.
Address Winfield, Kansas

STATE OF Kansas, COUNTY OF Sumner, ss.
(employee of owner) or (owner or operator) of the above-described well, being first duly sworn on oath, says: That I have knowledge of the facts, statements, and matters herein contained and the log of the above-described well as filed and that the same are true and correct. So help me God.

(Signature) *Pat Jenkins*

(Address)

SUBSCRIBED AND SWORN TO before me this 2 day of Sept, 19 61


Anna Thomas

Notary Public.

My commission expires 2-16-1962



15-191-00081-00-00

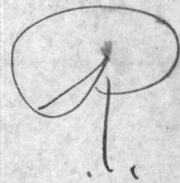

WELL LOG

Well: **H. H. JOHNSON 1-A**
Location: **SW NE NW, Sec. 22-34S-2W,**
Sumner County, Kansas
Owner: **Herndon Drilling Company**

Spudding date: **3-29-60**
Date casing set: **3-31-60**
Date rotary completed: **4-23-60**
Date cable completed:

<u>FROM</u>	<u>TO</u>	<u>FORMATION</u>	<u>REMARKS</u>
0	495	Surface Hole	Ran 17 joints 9-5/8" new casing.
495	2960	Shale and Lime	Set @ 492', cemented w/400 sx. Common
2960	2983	Sand	Cement, 2% CC added.
2983	3115	Sand, Shale and Lime	
3115	3300	Lime and Shale	
3300	3400	Lime, Sand and Shale	
3400	3855	Lime	
3855	3983	Lime and Shale	
3983	4085	Lime	
4085	4125	Chat	
4125	4525	Lime	
4525	4575	Sand	
	4575	Total Depth	Ran 131 joints 14# J-S new Nat. Tube Set @ 4213', cemented w/150 sx. cement.

HERNDON DRILLING COMPANY
WICHITA, KANSAS

RECEIVED
STATE CORPORATION COMMISSION

SEP 7 1961

CONSERVATION DIVISION
Wichita, Kansas

Subscribed and sworn to before me this 29th
day of April, 19 60

I certify the above and foregoing to be a true and exact copy
of the original driller's log on the H. H. Johnson 1-A

Johnnie Alene Dese
Notary Public
My commission expires:
June 19, 1961

HERNDON DRILLING COMPANY
C. T. Moore
By: _____
Title: **C. T. Moore, Asst. Secty.**