


STATE OF KANSAS
STATE CORPORATION COMMISSION

Form CP-4

Give All Information Completely
Make Required Affidavit
Mail or Deliver Report to:
Conservation Division
State Corporation Commission
212 No. Market
Wichita, Kansas

WELL PLUGGING RECORD

NORTH

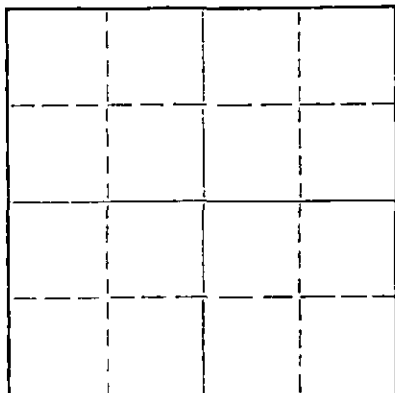

Locate well correctly on above
Section Plat

Sumner

County. Sec. 35 Twp. 34S Rge. 2 (E) (W)

Location as "NE/CNW/SW" or footage from lines C-NE, NW, NW

Lease Owner M-D Corporation, Inc.

Lease Name Dillard

Well No. 1

Office Address Union State Bank Bldg. Arkansas City, Kansas

Character of Well (completed as Oil, Gas or Dry Hole) Dry Hole

Date well completed October 25, 1966

Application for plugging filed October 25, 1966

Application for plugging approved October 25, 1966

Plugging commenced October 25, 1966

Plugging completed October 25, 1966

Reason for abandonment of well or producing formation Dry Hole

If a producing well is abandoned, date of last production 19

Was permission obtained from the Conservation Division or its agents before plugging was commenced? yes

Name of Conservation Agent who supervised plugging of this well Mr. Howard Hess

Producing formation none Depth to top Bottom Total Depth of Well 4628 Feet

Show depth and thickness of all water, oil and gas formations.

OIL, GAS OR WATER RECORDS

CASING RECORD

FORMATION	CONTENT	FROM	SIZE	PUT IN	PULLED OUT
			8 5/8"	182'	none

Describe in detail the manner in which the well was plugged, indicating where the mud fluid was placed and the method or methods used in introducing it into the hole. If cement or other plugs were used, state the character of same and depth placed, from feet to feet for each plug set.

260' to 4628 ft. hole filled with 9.5 lb. per gallon drilling mud with 44 viscosity.

100' to 260 ft. hole filled with 50 sacks regular cement mixed and pumped in hole by Halliburton thru open end drill pipe with bottom of pipe @ 260 ft.

8' to 50 ft. hole filled with 15 sacks regular cement mixed and pumped in hole by Halliburton thru open end drill pipe with bottom of pipe @ 50 ft.

Surface pipe cut off approximately 3 ft. below ground level, 2 sacks cement dumped in top of surface pipe.

Welder welded steel plate on top of surface pipe.

2 sacks cement dumped in top of Rat hole after boot was pulled.

(If additional description is necessary, use BACK of this sheet)

Name of Plugging Contractor McLennan Drilling Company

Address P. O. Box 6 Nowata, Oklahoma 74048

STATE OF _____, COUNTY OF _____, ss.

(employee of owner) or (owner or operator) of the above-described well, being first duly sworn on oath, says: That I have knowledge of the facts, statements, and matters herein contained and the log of the above-described well as filed and that the same are true and correct. So help me God.

(Signature)

Perry L. Goudy
1602 N. 7th St. Arkansas City 15000.
(Address)

SUBSCRIBED AND SWORN to before me this 22nd day of December, 1966

My commission expires

October 15, 1967

Notary Public.

WELL LOG

Company: M-D Corporation, Inc
127 S Summit
Arkansas City, Kansas

Dillard No. 1
C-NE, NW, NW Sec 35 34S 2W
Sumner County, Kansas

Contractor: McLennan Drilling Co
Nowata, Oklahoma

Casing Record:
182 ft 8-5/8" Surface

Well deepened from 1690' to 4628'

Commenced: 9/27/66 Completed: 10/25/66

D & A & Plugged

1690	Sand	4315	Miss Lime
1710	Shale	4360	Lime & Chert
1831	Sandy Shale & Lime	4393	Miss Lime
2059	Lime	4460	Miss Lime Cherty & Rough
2089	Shale	4475	Miss Lime
2113	Sandy Shale	4500	Miss Limestone hard
2138	Lime	4513	Limy Shale
2153	Sandy Lime & Shale	4578	Lime & Sand
2198	Lime	4582	Sand Simpson Hd Shrp
2432	Lime & Sandy Shale	4590	Sand (Simpson)
2495	Lime	4628	Total Depth
2552	Shale		
2567	Lime		
2582	Lime & Shale		
2669	Lime		
2690	Shale		
2724	Lime & Limy Shale		
2785	Lime & Shale		
2950	Limy Shale		
2989	Shale		
3031	Limy Shale		
3038	Shale		
3092	Lime		
3130	Sandy Shale		
3160	Limy Shale		
3220	Shale & Sandy Shale		
3369	Shale		
3390	Shale & Sand		
3425	Sand		
3448	Shale		
3474	Lime (Top of KC Lime)		
3509	Shale & Sandy Lime		
3535	Lime		
3878	Lime & Shale		
3890	Lime		
4065	Lime & Shale		
4130	Lime (Area Top Miss Chat 4150')		
4168	Hd Cherty Lime		
4178	Chat		
4201	Miss Lime		
4312	Shale		

RECEIVED
STATE CORPORATION COMMISSION
DEC 27 1966
CONSERVATION DIVISION
Wichita, Kansas