


Give All Information Completely
Make Required Affidavit
Mail or Deliver Report to:
Conservation Division
State Corporation Commission
212 No. Market
Wichita, Kansas

WELL PLUGGING RECORD

NORTH

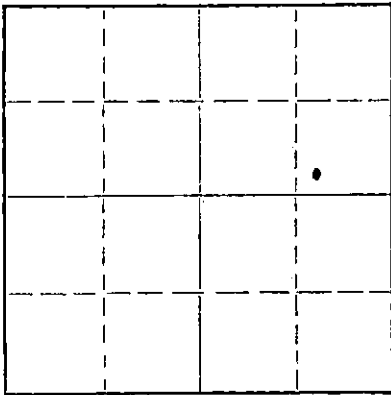

Locate well correctly on above
Section Plat

Sumner County, Sec. 2 Twp. 34S Rge. 3 (E) W (W)
Location as "NE/CNW/SW" or footage from lines C SW SE NE
Lease Owner Lee Phillips Oil Co.
Lease Name Watts Estate Well No. 1
Office Address 1532 Wichita Plaza, Wichita, Kansas
Character of Well (completed as Oil, Gas or Dry Hole) Dry Hole
Date well completed 3-13 1968
Application for plugging filed 3-13 1968
Application for plugging approved 3-13 1968
Plugging commenced 3-13 1968
Plugging completed 3-13 1968
Reason for abandonment of well or producing formation Dry Hole

If a producing well is abandoned, date of last production 19
Was permission obtained from the Conservation Division or its agents before plugging was commenced? Yes

Name of Conservation Agent who supervised plugging of this well Howard Hess
Producing formation Depth to top Bottom Total Depth of Well 4638' Feet
Show depth and thickness of all water, oil and gas formations.

OIL, GAS OR WATER RECORDS

CASING RECORD

FORMATION	CONTENT	FROM	TO	SIZE	PUT IN	PULLED OUT
Surface pipe		-0-	252	8 5/8"	252	-0-

Describe in detail the manner in which the well was plugged, indicating where the mud fluid was placed and the method or methods used in introducing it into the hole. If cement or other plugs were used, state the character of same and depth placed, from feet to feet for each plug set.

Filled hole with heavy mud.

#1 plug @ 245' with 25 sks. cement.

#2 plug @ 40' with 10 sks. cement.

#3 plug in rat hole with 2 sks. cement.

RECEIVED
STATE CORPORATION COMMISSION
MAR 18 1968
CONSERVATION DIVISION
Wichita, Kansas

(If additional description is necessary, use BACK of this sheet)
Name of Plugging Contractor Sweetman Drilling, Inc.
Address Box 645, Great Bend, Kansas 67530

STATE OF Kansas, COUNTY OF Barton, ss.

(employee of owner) or (owner or operator) of the above-described well, being first duly sworn on oath, says: That I have knowledge of the facts, statements, and matters herein contained and the log of the above-described well as filed and that the same are true and correct. So help me God.

(Signature) H. D. Sweetman
Box 645, Great Bend, Kansas

(Address)

SUBSCRIBED AND SWORN TO before me this 14 day of March, 1968

My commission expires 5-9-71

Notary Public.

WELL LOG
 Watts Estate #1
 C SW SE NE 2-34S-3W
 Sumner County, Kansas

FROM	TO	
0	305	Shale
305	685	Shale & shells
685	3193	Shale & Lime
3193	3218	Sand
3218	3495	Shale & Lime
3495	3860	Lime
3860	4235	Lime & Shale
4235	4540	Miss. Lime
4540	4628	Lime
4628	4638	Simp. Sand
4638		Total Depth

RECEIVED
 STATE CORPORATION COMMISSION
 MAR 18 1968
 CONSERVATION DIVISION
 Wichita, Kansas

STATE OF KANSAS

COUNTY OF BARTON ss

T. D. Sweetman, Partner of Sweetman Drilling, Inc., being first duly sworn on oath says: That I have knowledge of the facts, statements and matters herein contained and the log of the above described well as filed and that the same are true and correct.

T. D. Sweetman
 T. D. Sweetman

Subscribed and sworn before me this 13th day of March, 1968.

Reata L. Boyd
 Notary Public Barton County

My Commission Expires 5-9-71