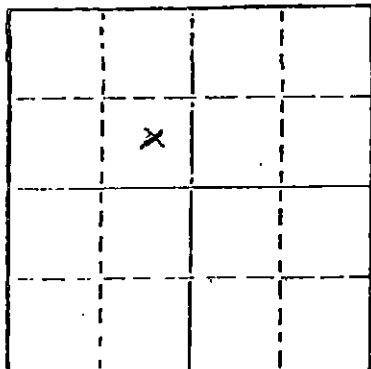


STATE OF KANSAS
STATE CORPORATION COMMISSION

WELL PLUGGING RECORD

Give All Information Completely
Make Required Affidavit
Mail or Deliver Report to
Conservation Division
State Corporation Comm.
245 North Water
Wichita, KS 67202

Locate well correctly on above
Section Plat

Morton County, Sec. 1 Twp. 33 Rge. 43 XX/W
Location as "NE/CNW1SW1" or footage from lines
1830' FNL; 1980' FWL Sec. 1

Lease Owner Cities Service Company
Lease Name Harrison C Well No. 1
Office Address 3545 NW 58th - Oklahoma City, OK 73112
Character of Well (Completed as Oil, Gas or Dry Hole)
Dry Hole

Date Well completed 12-28 1982
Application for plugging filed 19
Application for plugging approved 19
Plugging commenced 12-27- 1982
Plugging completed 12-28 1982
Reason for abandonment of well or producing formation
Dry Hole

If a producing well is abandoned, date of last production
19

Was permission obtained from the Conservation Division or
its agents before plugging was commenced? Yes

Name of Conservation Agent who supervised plugging of this well Clarence Thomas, Jr.
Producing formation Depth to top Bottom Total Depth of Well 5220'
Show depth and thickness of all water, oil and gas formations.

OIL, GAS OR WATER RECORDS

CASING RECORD

FORMATION	CONTENT	FROM	TO	SIZE	PUT IN	PULLED OUT
				9-5/8'	1392	None

Describe in detail the manner in which the well was plugged, indicating where the mud fluid was placed and the method or methods used in introducing it into the hold. If cement or other plugs were used, state the character of same and depth placed, from feet to feet for each plug set. RIH w/OE DP to 4850'; set 150 sx cmt plug from 4850; cmt plugs are 50/50 pozmix containing 3% CaCl; 4% gel; set 100 sx plug 3900-4100; 50 sx plug 3400-3500; 70 sx plug 1342-1442; 40 sx plug 460-570; spotted 10 sx cmt plug from 40' to surface. Filled Rat & Mouse hole w/10 sx cmt each. Cut off csg & welded on cap.

(If additional description is necessary, use BACK of this sheet)

Name of Plugging Contractor Johnson Drilling Co., Inc.

STATE OF Oklahoma COUNTY OF Oklahoma, ss.
Verlin Meier (employee of owner) or (owner or operator)
of the above-described well, being first duly sworn on oath, says: That I have knowledge of the facts, statements, and matters herein contained and the log of the above-described well as filed and that the same are true and correct. So help me God.

(Signature)

Verlin Meier - Prod. Region Mgr.3545 NW 58th - Oklahoma City, OK 73112

(Address)

SUBSCRIBED AND SWORN TO before me this 13th day of January, 19 83

Oliver E. Meneo

Notary Public.

RECEIVED
STATE CORPORATION COMMISSION

JAN 14 1983

CONSERVATION DIVISION
Wichita, Kansas