


STATE OF KANSAS
STATE CORPORATION COMMISSION

WELL PLUGGING RECORD

Give All Information Completely
Make Required Affidavit
Mail or Deliver Report to
Conservation Division
State Corporation Comm.
245 North Water
Wichita, KS 67202

Morton County, Sec. 2 Twp. 33S Rge. 43 XX/W
Location as "NE/CNW $\frac{1}{4}$ SW $\frac{1}{4}$ " or footage from lines
C SW/4 SW/4

Lease Owner Cities Service Oil & Gas Corporation
Lease Name Worthington A Well No. 3
Office Address 3545 N.W. 58th St., Okla. City, OK 73112
Character of Well (Completed as Oil, Gas or Dry Hole) Dry Hole
Date Well completed 8-1-1983
Application for plugging filed 19
Application for plugging approved 19
Plugging commenced 7-31-1983
Plugging completed 8-1-1983
Reason for abandonment of well or producing formation Dry Hole

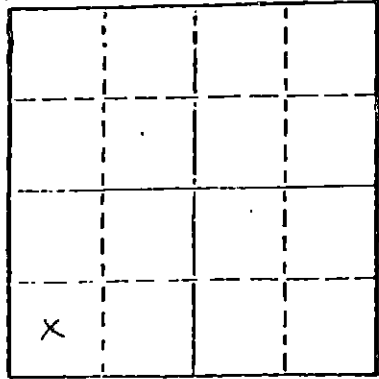

Locate well correctly on above
Section Plot

If a producing well is abandoned, date of last production 19
Was permission obtained from the Conservation Division or
its agents before plugging was commenced?

Name of Conservation Agent who supervised plugging of this well
Producing formation None Depth to top Bottom Total Depth of Well 5000'
Show depth and thickness of all water, oil and gas formations.

OIL, GAS OR WATER RECORDS

CASING RECORD

| FORMATION | CONTENT | FROM | TO | SIZE | PUT IN | PULLED OUT |
|-----------|---------|------|----|--------|--------|------------|
| | | | | 8-5/8" | 1363' | None |
| | | | | | | |
| | | | | | | |

Describe in detail the manner in which the well was plugged, indicating where the mud fluid was placed and the method or methods used in introducing it into the hold. If cement or other plugs were used, state the character of same and depth placed, from feet to feet for each plug set.

Ran OE drill pipe & spotted following OH cmt plugs:
35 sx Class "H" 4750-4650' Morrow
75 " " 3070-2870' Topeka
35 " " 1413-1313' Base of surface csg.
10 " " 40-30' Top Hole
15 sx in rat hole; 10 sx in mouse hole

(If additional description is necessary, use BACK of this sheet)

Name of Plugging Contractor Same as drilling contractor - Earl F. Wakefield, Inc.

STATE OF Oklahoma COUNTY OF Oklahoma, ss.
Verlin Meier (employee of owner) or (owner or operator)

of the above-described well, being first duly sworn on oath, says: That I have knowledge of the facts, statements, and matters herein contained and the log of the above-described well as filed and that the same are true and correct. So help me God.

(Signature) Verlin Meier
Production Region Mgr.
3545 N.W. 58th - Oklahoma City, Ok 73112
(Address)

SUBSCRIBED AND SWORN TO before me this 10th day of August, 19 83

Olive E. Mines
Notary Public.

My commission expires July 12, 1984

STA RECEIVED
AUG 17 1983