

15-129-20534-00-00

STATE OF KANSAS
STATE CORPORATION COMMISSION

WELL PLUGGING RECORD

Give All Information Completely
Make Required Affidavit
Mail or Deliver Report to
Conservation Division
State Corporation Comm.
245 North Water
Wichita, KS 67202

Morton County, Sec. 12 Twp. 33S Rge. 43 E/W
Location as "NE/CNW $\frac{1}{4}$ SW $\frac{1}{4}$ " or footage from lines
SW SW/4

Lease Owner Anadarko Production Company
Lease Name HATTERMAN "A" Well No. 1

Office Address P. O. Box 351, Liberal, Kansas 67901

Character of Well (Completed as Oil, Gas or Dry Hole)
DRY HOLE

Date Well completed July 2 1981

Application for plugging filed October 28 1981

Application for plugging approved verbal July 1 1981

Plugging commenced July 1 1981

Plugging completed July 2 1981

Reason for abandonment of well or producing formation
DRY HOLE


If a producing well is abandoned, date of last production
19

Was permission obtained from the Conservation Division or
its agents before plugging was commenced? YES

Name of Conservation Agent who supervised plugging of this well Mr. Clarence Thomas

Producing formation Depth to top Bottom Total Depth of Well 5220

Show depth and thickness of all water, oil and gas formations.

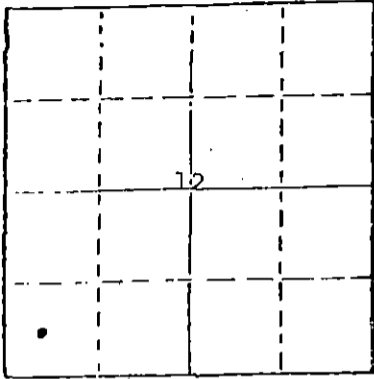

Locate well correctly on above
Section Plot

OIL, GAS OR WATER RECORDS

CASING RECORD

FORMATION	CONTENT	FROM	TO	SIZE	PUT IN	PULLED OUT
				8-5/8"	1330'	-0-

Describe in detail the manner in which the well was plugged, indicating where the mud fluid was placed and the method or methods used in introducing it into the hold. If cement or other plugs were used, state the character of same and depth placed, from _____ feet to _____ feet for each plug set.

Spotted 35 sxs cmt 3600-3550, spotted 35 sxs cmt 2742-2700, spotted 60 sxs cmt 1300-1200, spotted 25 sxs cmt 650-625, spotted 10 sxs cmt 40-0', 5 sxs each in rathole and mousehole.

RECEIVED
STATE CORPORATION COMMISSION

OCT 30 1981

(If additional description is necessary, use BACK of this sheet)
Name of Plugging Contractor Johnson Drilling Co., Inc.

CONSERVATION DIVISION
Wichita, Kansas

STATE OF KANSAS COUNTY OF SEWARD, ss.

Paul Campbell (employee of owner) or ~~XXXXXXXXXXXXXXXXXX~~
of the above-described well, being first duly sworn on oath, says: That I have knowledge of the facts, statements, and matters herein contained and the log of the above-described well as filed and that the same are true and correct. So help me God.

(Signature) Paul Campbell
P. O. Box 351, Liberal, Kansas 67901
(Address)

SUBSCRIBED AND SWORN TO before me this 29th day of October, 1981

BEVERLY J. WILLIAMS
Seward County, Kansas
My Comm. Expires November 21, 1982

Beverly J. Williams
Notary Public.

My commission expires