


STATE OF KANSAS  
STATE CORPORATION COMMISSION

15-677-6870-0000

Form CP-4

Give All Information Completely  
Make Required Affidavit  
Mail or Deliver Report to:  
Conservation Division  
State Corporation Commission  
P. O. Box 17027  
Wichita, Kansas 67217

WELL PLUGGING RECORD

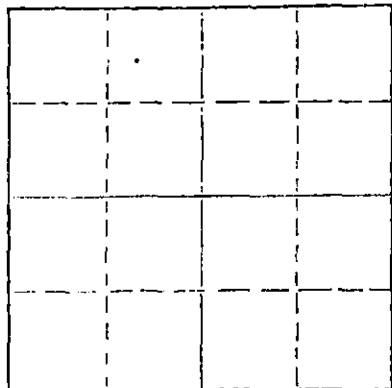

Locate well correctly on above Section Plat

Harper County, Sec. 25 Twp. 31 Rge. 9 (E) (W) X  
Location as "NE/CNW/SW" or footage from lines NW/NW/NW  
Lease Owner Mull Drilling Co.  
Lease Name ANTRIM Well No. 1  
Office Address P. O. Box 328, Attica, Kansas 67009  
Character of Well (completed as Oil, Gas or Dry Hole)  
Date well completed \_\_\_\_\_ 19\_\_\_\_  
Application for plugging filed \_\_\_\_\_ May 1, 19 74  
Application for plugging approved \_\_\_\_\_ 19\_\_\_\_  
Plugging commenced \_\_\_\_\_ May 28, 19 74  
Plugging completed \_\_\_\_\_ June 10, 19 74  
Reason for abandonment of well or producing formation Depleted  
If a producing well is abandoned, date of last production \_\_\_\_\_ 19\_\_\_\_  
Was permission obtained from the Conservation Division or its agents before plugging was commenced? Yes

Name of Conservation Agent who supervised plugging of this well G. R. Biberstein  
Producing formation \_\_\_\_\_ Depth to top \_\_\_\_\_ Bottom \_\_\_\_\_ Total Depth of Well 4370 Feet  
Show depth and thickness of all water, oil and gas formations.

OIL, GAS OR WATER RECORDS

CASING RECORD

FORMATION	CONTENT	FROM	TO	SIZE	PUT IN	PULLED OUT
				8 5/8	200	None
				4 1/2	4369	3026.40'

Describe in detail the manner in which the well was plugged, indicating where the mud fluid was placed and the method or methods used in introducing it into the hole. If cement or other plugs were used, state the character of same and depth placed, from \_\_\_\_\_ feet to \_\_\_\_\_ feet for each plug set.

Dumped sand to 4300' and 5 sacks cement. Worked pipe 26" on 2600 psi.  
Shot casing at 3800', 3700, 3600, 3500, 3400, 3300, 3200, 3100 and 3000'.  
Pulled a total of 95 joints of 4 1/2" casing. Pushed a plug to 250' and built a rock bridge. Plugged well with 5 yds. readymix concrete.

RECEIVED  
STATE CORPORATION COMMISSION  
JUN 18 1974  
CONSERVATION DIVISION  
Wichita, Kansas

(If additional description is necessary, use BACK of this sheet)  
Name of Plugging Contractor Rockhold Engineering, Inc.  
Address P. O. Box 698, Great Bend, Kansas 67530

STATE OF Kansas COUNTY OF Barton, ss.

James W. Rockhold (employee of owner) or (owner or operator) of the above-described well, being first duly sworn on oath, says: That I have knowledge of the facts, statements, and matters herein contained and the log of the above-described well as filed and that the same are true and correct. So help me God.

CATHY MILLER  
NOTARY PUBLIC  
Barton County, Ks.

(Signature) James W. Rockhold  
James W. Rockhold  
Box 698, Gt. Bend, Ks. 67530  
(Address)

Subscribed and sworn to before me this 17th day of June, 1974

My commission expires Sept. 30, 1975

Cathy Miller  
Notary Public.

15-077-00970-0050

ROTARY DRILLERS LOG

COMPANY: Mull Drilling Co., Inc. Et al  
Wichita, Kansas

ROTARY DRILLING COMMENCED: 7/6/61

CONTRACTOR: Mull Drilling Co., Inc.  
Wichita, Kansas

ROTARY DRILLING COMPLETED: 7/16/61

CASING RECORD: Set 8 5/8" @ 200' w/135 sx cmt.  
Set 4 1/2" @ 4369' w/100 sx cmt.

LOCATION: ANTRIM #1  
NW NW NW 25-31E-9W  
Harper County, Kansas

(Figures indicate bottom of formation - measurements from top of Rotary Bushing.)

700' Red Bed  
3217' Shale & Lime  
3675' Sandy Lime & Shale  
4091' Lime & Shale  
4143' Lime  
4344' Lime w/Shale  
4370' Mississippi Chert - total depth

RECEIVED  
STATE CORPORATION COMMISSION  
MAY 2 - 1974  
CONSERVATION DIVISION  
Wichita, Kansas

I hereby certify that this is a true and correct copy of the above log to the best of my knowledge.

MULL DRILLING COMPANY, INC.

*D. J. Costa*  
D. J. Costa, Geologist

STATE OF KANSAS }  
COUNTY OF SEDGWICK } SS

Subscribed and sworn to before me this 24th day of July, 1961.



*M. J. Miller*  
Notary Public