

FEB 11 1974


STATE OF KANSAS  
STATE CORPORATION COMMISSION

15-077-10105-0000 Form CP-4

Give All Information Completely  
Make Required Affidavit  
Mail or Deliver Report to:  
Conservation Division  
State Corporation Commission  
P. O. Box 17027  
Wichita, Kansas 67217  
NORTH

WELL PLUGGING RECORD

Harper County, Sec. 25 Twp. 31 Rge. 9 (E) W (W)  
Location as "NE/CNW/SW" or footage from lines SW NE SE  
Lease Owner Robin Supply Corp.  
Lease Name Antrim (Ray) Well No. 1  
Office Address 1322 East 50th ; Tulsa, Oklahoma  
Character of Well (completed as Oil, Gas or Dry Hole) \_\_\_\_\_  
Date well completed \_\_\_\_\_ 19\_\_\_\_  
Application for plugging filed December 19 73  
Application for plugging approved December 19 73  
Plugging commenced December 22 19 73  
Plugging completed January 24 19 74  
Reason for abandonment of well or producing formation \_\_\_\_\_

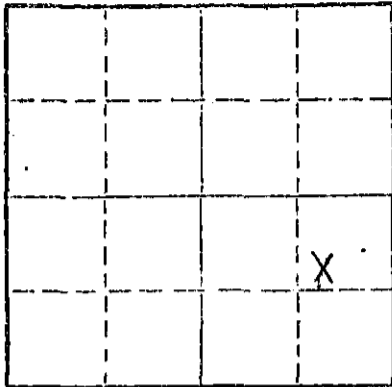

Locate well correctly on above  
Section Plot

If a producing well is abandoned, date of last production \_\_\_\_\_ 19\_\_\_\_  
Was permission obtained from the Conservation Division or its agents before plugging was commenced? Yes

Name of Conservation Agent who supervised plugging of this well Russell Biberstein  
Producing formation \_\_\_\_\_ Depth to top \_\_\_\_\_ Bottom \_\_\_\_\_ Total Depth of Well \_\_\_\_\_ Feet  
Show depth and thickness of all water, oil and gas formations.

OIL, GAS OR WATER RECORDS

CASING RECORD

FORMATION	CONTENT	FROM	TO	SIZE	PUT IN	PULLED OUT
				8 5/8"	220	None
				5 1/2"	4395	2921.45

Describe in detail the manner in which the well was plugged, indicating where the mud fluid was placed and the method or methods used in introducing it into the hole. If cement or other plugs were used, state the character of same and depth placed, from \_\_\_\_\_ feet to \_\_\_\_\_ feet for each plug set.

December 22, 1973 Plugged off bottom. Dumped sand to 4000'. Mixed and dumped 5 sx of cement.

January 24, 1974 Plugged off top. Set 10' rock bridge at 360'. Filled 8 5/8" surface casing and hole from 360' to base of cellar with 3000 lb. P.S.I. ready-mix concrete.

RECEIVED  
STATE CORPORATION COMMISSION  
NOV 14 1974  
CONSERVATION DIVISION  
Wichita, Kansas

(If additional description is necessary, use BACK of this sheet)  
Name of Plugging Contractor RUSS CASING PULLING, INC.  
Address P. O. Box 1082 ; Great Bend, Kansas 67530

STATE OF Oklahoma, COUNTY OF Tulsa, ss.  
Marvin Robinowitz (employee of owner) or (owner or operator) of the above-described well, being first duly sworn on oath, says: That I have knowledge of the facts, statements, and matters herein contained and the log of the above-described well as filed and that the same are true and correct. So help me God.

(Signature) Marvin Robinowitz  
6650 South Lewis, Tulsa, Oklahoma 74136  
(Address)

SUBSCRIBED AND SWORN to before me this 11th day of November, 19 74

My commission expires January 14, 1978  
Donna M. Lindsey Notary Public.

WELL LOG BUREAU--KANSAS GEOLOGICAL SOCIETY

503 East Murdock,

Wichita, Kansas

COPY


Company- CARTER OIL CO.  
Farm- Antrim-Campbell No. 1

SEC. 25 T. 31 R. 9W  
SW NE SE

15-077-10105-0000

Total Depth. 4396'  
Comm. 8-18-54 Comp. 11-24-54  
Shot or Treated.  
Contractor. Adkins Drlg. Co., Inc.  
Issued. 3-26-55

County Harper  
KANSAS

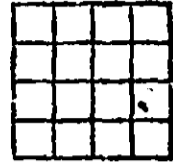

CASING:  
8 5/8" 220' cem w/175 sx  
5 1/2" 4395'

Elevation. 1574' RB

Production. 34 BO

Figures Indicate Bottom of Formations.

sand	60
red bed & shells	200
red bed	220
red bed	1340
shale & shells	1716
lime	1741
shale & lime	2590
shale	2670
lime & shale	2748
shale & lime	3210
lime	3480
shale & lime	4017
lime	4051
shale & lime	4195
lime & shells	4368
lime	4376
Core #1	4376-4377
Core #2	4377-4386
Core #3	4386-4396
Total Depth	

Tops: Scout	
Lansing	3645
Mississippi	4375

RECEIVED  
STATE CORPORATION COMMISSION  
JAN 2 1974  
CONSERVATION DIVISION  
Wichita, Kansas

*Plugging record from  
Russ casing coming  
in mail for Robin Supply*