


Give All Information Completely  
Make Required Affidavit  
Mail or Deliver Report to:  
Conservation Division  
State Corporation Commission  
212 North Market, Insurance Bldg.  
Wichita, Kansas

15-077-01025-0000

*This location  
verified by telephone  
conversation with  
J. Pike 2-20-63*

WELL PLUGGING RECORD

NORTH

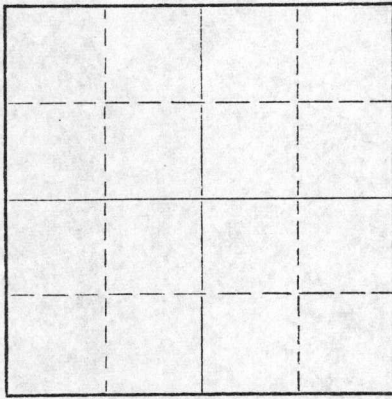

Locate well correctly on above  
Section Plat

Harper County. Sec. 26 Twp. 31S Rge. (E) 9 (W)  
Location as "NE/CNW/SW" or footage from lines C N/2 SE/4 SW/4  
Lease Owner Pickrell Drilling Company  
Lease Name Rall "C" Well No. 2  
Office Address 705 4th Nat'l Bank Bldg., Wichita 2, Kansas  
Character of Well (completed as Oil, Gas or Dry Hole) Dry Hole  
Date well completed February 16, 19 61  
Application for plugging filed February 16, 19 61  
Application for plugging approved February 16, 19 61  
Plugging commenced February 16, 19 61  
Plugging completed February 16, 19 61  
Reason for abandonment of well or producing formation Dry Hole

If a producing well is abandoned, date of last production 19  
Was permission obtained from the Conservation Division or its agents before plugging was commenced? Yes

Name of Conservation Agent who supervised plugging of this well Fred W. Hampel, Pretty Prairie, Kansas  
Producing formation Depth to top Bottom Total Depth of Well 4482 Feet  
Show depth and thickness of all water, oil and gas formations.

OIL, GAS OR WATER RECORDS

CASING RECORD

FORMATION	CONTENT	FROM	TO	SIZE	PUT IN	PULLED OUT
				8 5/8"	211'	None

Describe in detail the manner in which the well was plugged, indicating where the mud fluid was placed and the method or methods used in introducing it into the hole. If cement or other plugs were used, state the character of same and depth placed, from feet to feet for each plug set.

Heavy mud to 210'. Set plug. Cement with 15 sacks cement. Heavy mud to 40'. Cement with 10 sacks from plug to bottom of cellar. Plug rat hole with 2 sacks cement.

RECEIVED  
STATE CORPORATION COMMISSION

FEB 23 1961

CONSERVATION DIVISION  
Wichita, Kansas

(If additional description is necessary, use BACK of this sheet)

Name of Plugging Contractor Pickrell Drilling Company  
Address 705 4th Nat'l Bank Bldg., Wichita 2, Kansas

STATE OF KANSAS, COUNTY OF SEDGWICK, ss.  
C. W. Sebitt (employee of owner) or (owner or operator) of the above-described well, being first duly sworn on oath, says: That I have knowledge of the facts, statements, and matters herein contained and the log of the above-described well as filed and that the same are true and correct. So help me God.

(Signature) *C. W. Sebitt*  
705 4th Nat'l Bank Bldg., Wichita 2, Kansas  
(Address)

SUBSCRIBED AND SWORN TO before me this 22nd day of February, 1961

My commission expires March 7, 1964  
Marilyn A. Davis Notary Public.



ROTARY DRILLING LOG

15-017-01025-0000

COMPANY: Pickrell Drilling Company
705 Fourth National Bank Building
Wichita 2, Kansas NE
LOCATION: Rall "C" #2, C N/2 SE/4 SW/4
Sec. 26-31S-9W, Harper County, Kansas

Rotary Drilling Commenced 2-4-61

Rotary Drilling Completed 2-16-61

CONTRACTOR: PICKRELL DRILLING COMPANY
Wichita, Kansas

CASING RECORD: Ran 10 jts. 20# 8 5/8" Spiralweld Csg: Set @ 211' w/150 sks. Circ.
D & A, no oil string.

LOG

(Figures indicate bottom of formation — measurements from top of rotary bushing.)

Table with 3 columns: Depth (65', 211, 1090, 1380, 1525, 2150, 3640, 3702, 4188, 4412, 4482), Formation (Sand, Red bed, Redrock, shale, Shale, shells, Lime, shale, Lime, Lime, Lime, shale, Lime (sandy), Lime, Lime, shale, Miss. T.D.), and Circulate for Samples (4420', 4427, 4437, 4447, 4457, 4467, 4482).

Slope Test

1500' 0°
3235 0°
4400 0°

S.L.M.

1800' OK
3235 OK
3405 OK
4480 OK

RECEIVED
STATE CORPORATION COMMISSION

FEB 23 1961

CONSERVATION DIVISION
Wichita, Kansas

The undersigned, C. W. Sebitts, Attorney-in-Fact for PICKRELL DRILLING COMPANY, hereby certifies in behalf of said Company, that the above is a true and correct log of the formation encountered in drilling the above well as reflected by the Daily Drilling Reports.

PICKRELL DRILLING COMPANY
By [Signature] Attorney-in-Fact

STATE OF KANSAS }
COUNTY OF SEDGWICK } ss.:

On this 22nd day of February, 19 61, before me the undersigned, a Notary Public, in and for

the County and State aforesaid, personally appeared C. W. Sebitts, to me known to be the identical person who subscribed the name of PICKRELL DRILLING COMPANY to the foregoing instrument as its Attorney-in-Fact and acknowledged to me that he executed the same as his free and voluntary act and deed, and as the free and voluntary act and deed of such company, for the uses and purposes therein set forth.

Given under my hand and seal of office the day and year last above written.

My commission expires: March 7, 1964

[Signature]
Notary Public
Marilyn A. Davis