


WELL PLUGGING RECORD

Give All Information Completely
Make Required Affidavit
Mail or Deliver Report to:
Conservation Division
State Corporation Commission
211 No. Broadway
Wichita, Kansas

Harper County, Sec. 34 Twp. 31S Rge. (E) 9 (W)
Location as "NE/CNW/SW" or footage from lines NE NE NE
Lease Owner Earl F. Wakefield
Lease Name Newberry Well No. 1
Office Address 515 Union Center Bldg., Wichita, Kansas
Character of Well (completed as Oil, Gas or Dry Hole) Gas Well
Date well completed March 30 19 55
Application for plugging filed October 15 19 57
Application for plugging approved October 15 19 57
Plugging commenced October 15 19 57
Plugging completed October 20 19 57
Reason for abandonment of well or producing formation Not Eco.

NORTH

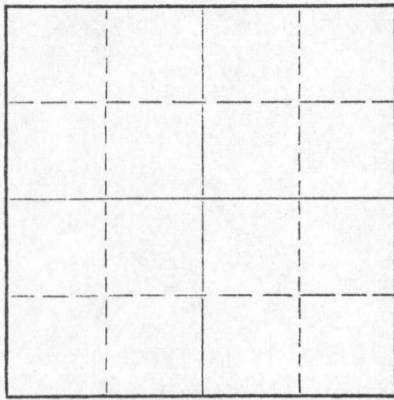

Locate well correctly on above
Section Plat

If a producing well is abandoned, date of last production March 31 19 57
Was permission obtained from the Conservation Division or its agents before plugging was commenced? Yes

Name of Conservation Agent who supervised plugging of this well Donald Truan
Producing formation _____ Depth to top _____ Bottom _____ Total Depth of Well 4400 Feet
Show depth and thickness of all water, oil and gas formations.

OIL, GAS OR WATER RECORDS

CASING RECORD

FORMATION	CONTENT	FROM	TO	SIZE	PUT IN	PULLED OUT
				8 5/8"	234	None
				5 1/2"	4400	3512

Describe in detail the manner in which the well was plugged, indicating where the mud fluid was placed and the method or methods used in introducing it into the hole. If cement or other plugs were used, state the character of same and depth placed, from _____ feet to _____ feet for each plug set.

Pumped 17 sacks cement in formation (top cement 4123)
Pumped 70 sacks Aquajel behind 5 1/2"
Pull 5 1/2", cement & rock bridge 210' to 155'
Filled hole to 20' with dirt, put 5 sacks
cement on top

(If additional description is necessary, use BACK of this sheet)
Name of Plugging Contractor Earl F. Wakefield
Address 515 Union Center Bldg., Wichita, Kansas

STATE OF KANSAS, COUNTY OF SEDGWICK, ss.
Earl F. Wakefield (Employee of owner) or (owner or operator) of the above-described well, being first duly sworn on oath, says: That I have knowledge of the facts, statements, and matters herein contained and the log of the above-described well as filed and that the same are true and correct. So help me God.

(Signature) Earl F. Wakefield
515 Union Center Bldg.
(Address)

SUBSCRIBED AND SWORN TO before me this 29th day of October, 19 57

My commission expires July 26, 1958 C. A. Snow Notary Public.

RECEIVED
STATE CORPORATION COMMISSION

OCT 30 1957

CONSERVATION DIVISION
Wichita, Kansas

PLUGGING
FILE SEC 34T 31R 9W
BOOK PAGE 50 LINE 29

Newberry #1
Owners: Earl F. Wakefield
and et al
Contractor: Earl F. Wakefield
Comm. 3/17/55 Comp: 3/30/55

NE NE NE
34-31S-9W
Harper County, Kansas
Casing: 234' of 8 5/8"
4400' of 5 1/2"

Elevation: 1599 R. B.

Surface	246
Red Bed	530
Red Bed, Shale & Shells	1480
Shale & Shells	1720
Shale, Lime & Shells	1915
Lime & Shale	2115
Shale & Shells	2616
Shale & Lime	3290
Shale, Lime & Sand	3380
Lime & Shale	3559
Top Douglas 3580	
Shale & Sand	3650
Shale & Lime	3735
Lime	3878
Lime & Shale	3955
Lime	4145
Shale	4205
Shale & Shells	4318
Shale	4381
Lime (Mississippi)	4400
Total Rotary Depth	4400

STATE OF KANSAS)
) SS
COUNTY OF SEDGWICK)

I hereby agree and certify that the above is a true and correct copy of the log on the Newberry #1 well located NE NE NE, 34-31S-9W, Harper County, Kansas.

Earl F. Wakefield

Sworn and subscribed before me this 6th day of April, 1955.

[Signature]
Notary Public

My commission expires July 26, 1958.

RECEIVED
STATE OF KANSAS

OCT 30 1957

REGISTRATION DIVISION
Wichita, Kansas

PLUGGING	
FILE	SEC. 34 T. 31. R. 9W
BOOK	PAGE 50 LINE 29