

15-191-01449-00-00

STATE OF KANSAS
STATE CORPORATION COMMISSION

WELL PLUGGING RECORD

Give All Information Completely
Make Required Affidavit
Mail or Deliver Report to:
Conservation Division
State Corporation Commission
211 No. Broadway
Wichita, Kansas

Summer County. Sec. 1 Twp. 30s Rge. 1 (E) W (W)

Location as "NE/CNW/SW" or footage from lines SW NE NW

Lease Owner Mull Drlg. Co. Inc.

Lease Name Kerley Well No. 2

Office Address 670 N. 4th. Natl. Bank Bldg. Wichita, Kansas

Character of Well (completed as Oil, Gas or Dry Hole) Dry Hole

Date well completed 2-7 60 19

Application for plugging filed 2-7-60 19

Application for plugging approved 2-7-60 19


Plugging commenced 9:00 am. 2-7-60 19

Plugging completed 10:00 am. 2-7-60 19

Reason for abandonment of well or producing formation Non Productive.

If a producing well is abandoned, date of last production _____ 19

Was permission obtained from the Conservation Division or its agents before plugging was commenced? Yes

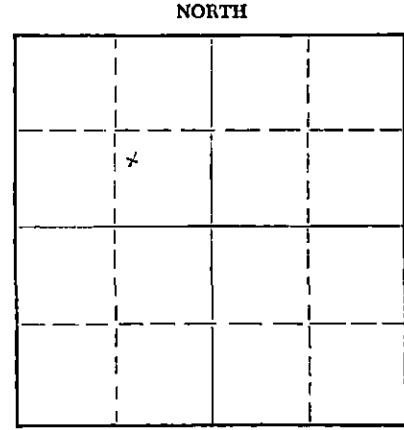

Locate well correctly on above Section Plat

Name of Conservation Agent who supervised plugging of this well Graham

Producing formation _____ Depth to top _____ Bottom _____ Total Depth of Well 3860 Feet

Show depth and thickness of all water, oil and gas formations.

OIL, GAS OR WATER RECORDS

CASING RECORD

FORMATION	CONTENT	FROM	TO	SIZE	PUT IN	PULLED OUT

Describe in detail the manner in which the well was plugged, indicating where the mud fluid was placed and the method or methods used in introducing it into the hole. If cement or other plugs were used, state the character of same and depth placed, from _____ feet to _____ feet for each plug set.

Hole filled with mud to depth of 240 ft. A plug was pushed to this depth with drill pipe, $\frac{1}{2}$ sack hulls was put on top of plug and then 20 sacks cement was added through drill pipe. Hole was then filled within 40 ft. of top of hole and a second plug was put in on top of mud. $\frac{1}{2}$ sack hulls was put on top of plug and 10 sacks cement put on top of plug filling hole to top of surface pipe. Rat Hole was bridged and 2 sacks cement put in top to finish plugging job.

RECEIVED
STATE CORPORATION COMMISSION

FEB 10 1960

CONSERVATION DIVISION
Wichita, Kansas

Name of Plugging Contractor Co. Tools
Address _____
(If additional description is necessary, use BACK of this sheet)

STATE OF Kansas, COUNTY OF Harper, ss.
Joseph O. Butts (employee of owner) or (owner or operator) of the above-described well, being first duly sworn on oath, says: That I have knowledge of the facts, statements, and matters herein contained and the log of the above-described well as filed and that the same are true and correct. So help me God.

(Signature) Joseph O. Butts

(Address) _____

SUBSCRIBED AND SWORN TO before me this 9th day of February, 19 60

My commission expires Feb. 24, 1960. Madge N. Miller Notary Public.



R

ROTARY DRILLERS LOG

COMPANY: Mull Drilling Co., Inc.
Wichita, Kansas

ROTARY DRILLING COMMENCED: 1-26-60

CONTRACTOR: Mull Drilling Co., Inc.
Wichita, Kansas

ROTARY DRILLING COMPLETED: 2-7-60

CASING RECORD: Set 350' of 8 5/8" csg.
w/400 sax cmt.
D & A

LOCATION: KERLEY #2
SW NE NW 1-30S-1W
Sumner County, Kansas

(Figures indicate bottom of formation - measurements from top of Rotary Bushing)

435'	Lime
2290'	Shale & Lime
2625'	Sandy Lime & Shale
2794'	Lime & Shale
2913'	Kansas City
3374'	Lime & Shale
3418'	Mississippi Chert & Lime
3573'	Mississippi Lime
3683'	Mississippi Chert & Lime
3830'	Lime & Shale
3860'	Simpson Total Depth

RECEIVED
STATE CORPORATION COMMISSION
FEB 12 1960
COMMISSION
WICHITA, KANSAS


I hereby certify that this is a true and correct copy of the above log to the best of my knowledge.

MULL DRILLING COMPANY, INC.

R. James Gear
R. James Gear

STATE OF KANSAS)
COUNTY OF SEDGWICK) SS

Subscribed and sworn to before me this 11th day of February, 1960.

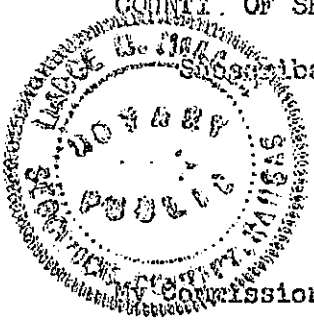

Madge N. Miller
Madge N. Miller, Notary Public

My Commission Expires: February 24, 1960