

15-191-30118-00-00

SP

STATE OF KANSAS
STATE CORPORATION COMMISSION

Form CP-4

Give All Information Completely
Make Required Affidavit
Mail or Deliver Report to:
Conservation Division
State Corporation Commission
212 No. Market
Wichita, Kansas

WELL PLUGGING RECORD

SUMNER County, Sec. 1 Twp. 30S Rge. (E) 1 (W)

Location as "NE/CNW&SW&" or footage from lines SW SE NW

Lease Owner REX & MORRIS DRILLING COMPANY, ET AL

Lease Name KIRLEY Well No. 1

Office Address P. O. BOX 334, EL DORADO, KANSAS 67042

Character of Well (completed as Oil, Gas or Dry Hole) DRY HOLE

Date well completed 30 MAY 19 66

Application for plugging filed 30 MAY 19 66

Application for plugging approved 30 MAY 19 66


Plugging commenced 30 MAY 19 66

Plugging completed 30 MAY 19 66

Reason for abandonment of well or producing formation DRY HOLE

If a producing well is abandoned, date of last production NONE 19

Was permission obtained from the Conservation Division or its agents before plugging was commenced? YES

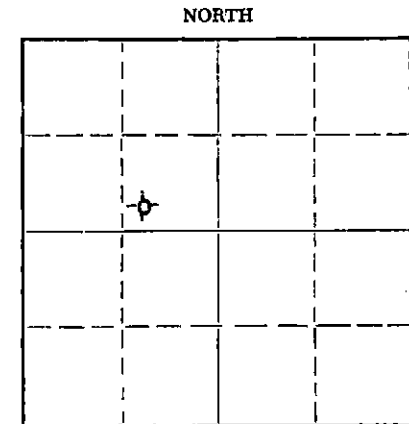

Locate well correctly on above Section Plat

Name of Conservation Agent who supervised plugging of this well H. E. HESS

Producing formation NONE Depth to top Bottom Total Depth of Well 3860 Feet

Show depth and thickness of all water, oil and gas formations.

OIL, GAS OR WATER RECORDS

CASING RECORD

FORMATION	CONTENT	FROM	TO	SIZE	PUT IN	PULLED OUT
SURFACE HOLE	WATER	SURFACE	332' RB	8 5/8" OD	327.13'	LEFT IN
(SEE ATTACHED LOG)						

Describe in detail the manner in which the well was plugged, indicating where the mud fluid was placed and the method or methods used in introducing it into the hole. If cement or other plugs were used, state the character of same and depth placed, from _____ feet to _____ feet for each plug set.

FILED HOLE WITH DRILLING MUD TO 250', SET PLUG AND HULLS AND CEMENT WITH 15 SACKS CEMENT,
FILL HOLE WITH DRILLING MUD TO 35', SET PLUG AND HULLS AND CEMENT WITH 8 SACKS CEMENT,
PUT 2 SACKS CEMENT IN RAT HOLE.

RECEIVED
STATE CORPORATION COMMISSION
JUN 20 1966
6-29-66

(If additional description is necessary, use BACK of this sheet)

Name of Plugging Contractor REX & MORRIS DRILLING COMPANY

Address P. O. BOX 334, EL DORADO, KANSAS 67042

STATE OF KANSAS, COUNTY OF BUTLER, ss. A. H. FISHER

(employee of owner) or (owner or operator) of the above-described well, being first duly sworn on oath, says: That I have knowledge of the facts, statements, and matters herein contained and the log of the above-described well as filed and that the same are true and correct. So help me God.

(Signature) [Signature]

P.O. BOX 334, EL DORADO, KANSAS (Address)

SUBSCRIBED AND SWORN TO before me this 24TH day of JUNE, 19 66

My commission expires 5 MAY 1969

[Signature] HAZEL N. DILTS Notary Public.

KERLEY #1

REX & MORRIS, ETAL

Elevation 1245' RB
1240' GL

Total Depth: 3860' RB
Contractor: Rex & Morris
Commenced: 5-23-66
Completed: 5-30-66
Initial Prod.: D & A

Location: SW SE NW
Section 1-30S-1W
Sumner County, Kansas

Casing Record:
8 5/8" OD Set 332' RB
w/250 sacks

FORMATION	DEPTH
Surface Hole	332'
Lime & Shale	1155'
Shale	1290'
Shale & Lime	2088'
Lime & Shale	2140'
Shale	2450'
Lime - Brown	2455'
Sand - Stalnaker	2615'
Shale	2792'
Lime - Kansas City	3019'
Lime - Checkerboard	3069'
Lime & Shale	3265'
Shale & Lime	3375'
Lime - Mississippi	3771'
Shale - Kinderhook	3832'
Sand - Simpson - R.T.D.	3860'

RECEIVED
STATE COMMISSIONER OF GEOL. & MINES
JUN 29 1966

I hereby certify the foregoing statements are true and correct to the best of my knowledge and belief.

Rex & Morris Drilling Company

By A. H. Fisher
A. H. Fisher

STATE OF KANSAS
COUNTY OF BUTLER, SS.

Subscribed and sworn to before me, a Notary Public, this 23rd day of June, 1966.

Hazel M. Dilts
Hazel M. Dilts, Notary Public

My commission expires: May 5, 1969