


STATE OF KANSAS
STATE CORPORATION COMMISSION

Give All Information Completely
Make Required Affidavit
Mail or Deliver Report to:
Conservation Division
State Corporation Commission
211 No. Broadway
Wichita, Kansas

WELL PLUGGING RECORD

15-191-00824-00-00

NORTH

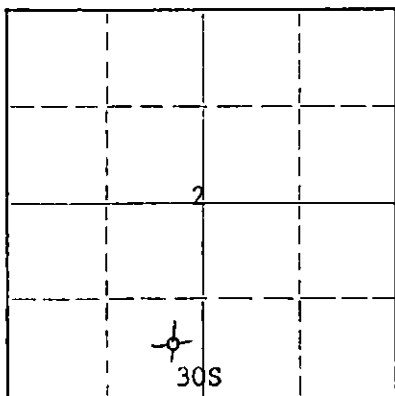

Locate well correctly on above
Section Plat

1W

Sumner County. Sec. 2 Twp. 30S Rge. (E) 1 (W)
Location as "NE/CNW/SW" or footage from lines SE/4 SE/4 SW/4
Lease Owner N.C.R.A., Walters Drilling Co., O.E. Bradley
Lease Name Stunkel Well No. 1
Office Address 510 Orpheum Building, Wichita 2, Kansas
Character of Well (completed as Oil, Gas or Dry Hole) Dry Hole
Date well completed June 22, 19 58
Application for plugging filed (verbal) June 22, 19 58
Application for plugging approved (verbal) June 22, 19 58
Plugging commenced June 23, 19 58
Plugging completed June 23, 19 58
Reason for abandonment of well or producing formation Dry Hole

If a producing well is abandoned, date of last production 19
Was permission obtained from the Conservation Division or its agents before plugging was commenced? Yes

Name of Conservation Agent who supervised plugging of this well Eugene Graham, Winfield, Kansas
Producing formation None Depth to top Bottom Total Depth of Well 3920 Feet
Show depth and thickness of all water, oil and gas formations.

OIL, GAS OR WATER RECORDS

CASING RECORD

FORMATION	CONTENT	FROM	TO	SIZE	PUT IN	PULLED OUT
None	None	0	222'	8 5/8"	222'	None
	No oil string - D & A					

Describe in detail the manner in which the well was plugged, indicating where the mud fluid was placed and the method or methods used in introducing it into the hole. If cement or other plugs were used, state the character of same and depth placed, from feet to feet for each plug set.

Filled hole with heavy mud to 210', set bottom plug at 210'
with 1/2 sack Hulls and 15 sacks cement.

Filled hole with heavy mud to 35', set top plug at 35' with hulls and
10 sacks cement

(If additional description is necessary, use BACK of this sheet)
Name of Plugging Contractor Walters Drilling Co.
Address 510 Orpheum Building, Wichita 2, Kansas

STATE OF Kansas COUNTY OF Sedgwick, ss.
Robert F. Walters (owner or operator) of the above-described
well, being first duly sworn on oath, says: That I have knowledge of the facts, statements, and matters herein contained and the log of the
above-described well as filed and that the same are true and correct. So help me God.


(Signature)

510 Orpheum Building, Wichita 2, Kansas
(Address)

SUBSCRIBED AND SWORN TO before me this 26th day of June 19 58

My commission expires March 10, 1960

Notary Public.

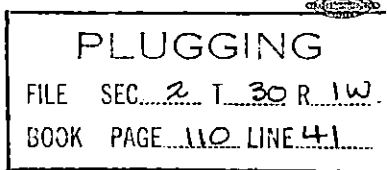

RECEIVED
STATE CORPORATION COMMISSION

JUN 27 1958

CONSERVATION DIVISION
Wichita, Kansas

15-191-00824-00-00

STUNKEL NO. 1

Location: SE/4 SE/4 SW/4 Sec. 2-30S-1W, Date Spudded: 6-10-58
 Sumner County, Kansas

Operator: Walters Drilling Co. Completion: 6-23-58

Contractor: Walters Drilling Co. Elevation: 1239 Gr
 1242 DF
 1244 KB

Surface Casing: 8 5/8" set at 222' with
 175 sacks cement and 3
 Cal. Chloride

Oil String: None. D & A

L O G

(Figures indicate bottom of formation)

Surface	0 to 222
Shale and Shells	585
Shale and Salt	700
Shale and Lime	2473
Sand and Shale	2525
Shale and Lime	2880
Lime	3020
Lime and Shale	3235
Shale	3410
Lime	3485
Lime and Shale	3510
Lime	3580
Lime and Shale	3725
Lime	3760
Lime and Shale	3835
Shale and Sand	3865
Sand	3920
Total Depth	3920

The undersigned, Robert F. Walters, hereby certifies that the above log is a true and correct log of the formations encountered in drilling the above noted well as reflected by the Daily Drilling Reports.

WALTERS DRILLING CO.

By

Robert F. Walters

Subscribed and sworn to before me
 this 26th day of June, 1958

Pauline Hudrickson
 Notary Public

My commission expires:
 March 10, 1960

PLUGGING			
FILE	SEC	T	R
	2	30	1W
BOOK	PAGE	LINE	
	110	41	

RECEIVED
 CORPORATION COMMISSION

JUN 27 1958

CONSERVATION DIVISION
 Wichita, Kansas