


STATE OF KANSAS
STATE CORPORATION COMMISSION

Give All Information Completely
Make Required Affidavit
Mail or Deliver Report to:
Conservation Division
State Corporation Commission
212 North Market, Insurance Bldg.
Wichita, Kansas

WELL PLUGGING RECORD

Pratt County. Sec. 17 Twp. 28 Rge. 13 (E) (W)^{SE}

Location as "NE/CNW/SW" or footage from lines SE SE NE/4
Lease Owner (S. A. Murphy
Lease Name 712 Brown Bldg. Wichita 2, Kansas Well No. 1
Office Address Frank L. Smith #1
Character of Well (completed as Oil, Gas or Dry Hole) dry hole
Date well completed Febr. 2, 1962 19
Application for plugging filed " 19
Application for plugging approved " 19
Plugging commenced " 19
Plugging completed " 19
Reason for abandonment of well or producing formation _____

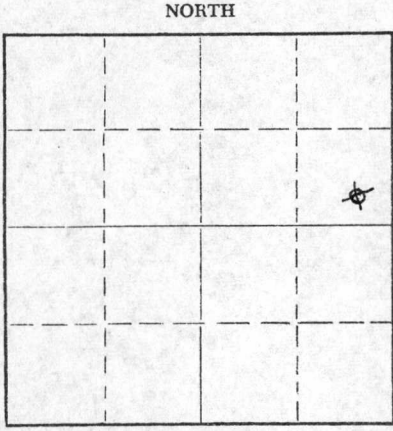

Locate well correctly on above Section Plat


If a producing well is abandoned, date of last production _____ 19
Was permission obtained from the Conservation Division or its agents before plugging was commenced? yes

Name of Conservation Agent who supervised plugging of this well W. L. Lac Kamp Jr.
Producing formation _____ Depth to top _____ Bottom _____ Total Depth of Well 4600 Feet
Show depth and thickness of all water, oil and gas formations.

OIL, GAS OR WATER RECORDS				CASING RECORD		
FORMATION	CONTENT	FROM	TO	SIZE	PUT IN	PULLED OUT
		0	300	8 5/8"	300	none

Describe in detail the manner in which the well was plugged, indicating where the mud fluid was placed and the method or methods used in introducing it into the hole. If cement or other plugs were used, state the character of same and depth placed, from _____ feet to _____ feet for each plug set.

Mudded to 300 - set plug w/20 x cement
Mudded to 35 - set plug w/10 sx cement to top

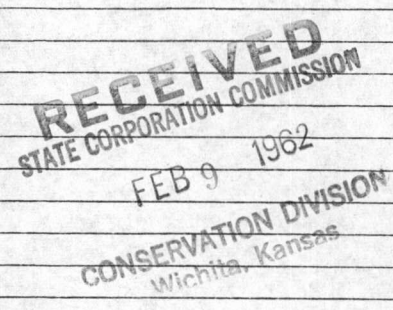

(If additional description is necessary, use BACK of this sheet)
Name of Plugging Contractor Virginia Drilling Co Inc.
Address 712 Brown Bldg. Wichita 2, Kansas

STATE OF Kansas, COUNTY OF Sedgwick, ss.
Murlee Hawkins (employee of owner) or (owner or operator) of the above-described well, being first duly sworn on oath, says: That I have knowledge of the facts, statements, and matters herein contained and the log of the above-described well as filed and that the same are true and correct. So help me God.

(Signature) Murlee Hawkins
712 Brown Bldg. Wichita 2, Kansas
(Address)

SUBSCRIBED AND SWORN TO before me this 8th day of February, 19 62

Inez M. Underwood
Notary Public.

My commission expires March 15, 1962



Frank L. Smith # 1 - SE SE NE/4 Section 17-28-13 Pratt County, Kansas
 Company - S. A. Murphy
 Contractor - Virginia Drlg Co Inc.
 Commenced - January 15, 1962
 Completed - February 2, 1962
 Elevation - 1937 KB
 Total Depth - 4600 - D. H. 8 5/8" set at 300' w/175 sx. cem.

FORMATION	DEPTH	TOPS:
Clay - sand	0- 100	
Sand	100- 170	
Red bed	170- 300	
Redbed-Anhydrite-shale-shells	300-1300	
Shale-shells	1300-1910	
Sandy lime	1910-2035	3675 - Heebner
Sandy lime - shells	2035-2220	3711 - Douglas FM
Lime	2220-2355	3862 - Brn lime
Lime-shale	2355-2530	3877 - Lansing
Shale-shells-sandy	2530-2655	4230 - Base Lansing
Lime-shale	2655-3300	4298 - Basal Marm. Cherty lime
Lime-sandy shale	3300-3425	
Lime-shale	3425-3550	4337 - Mississippi
Lime	3550-3573	4397 - Viola
Sandy lime	3573-3604	4468 - Simpson shale
Lime-shale	3604-3755	4475 - " sandy Dol.
Lime-shale streaks	3755-3875	4596 - " sand
Lime	3875-4265	4573 - Arbuckle
Lime-chert	4265-4292	
Lime	4292-4327	
Chert-lime-shale	4327-4400	
Chert	4400-4410	
Lime-shale-chert	4410-4480	
Lime shale	4480-4600 TD	

Nancy Dawson

RECEIVED
 STATE CORPORATION COMMISSION
 FEB 9 1962
 CONSERVATION DIVISION
 Wichita, Kansas

Subscribed and sworn to before me, a Notary Public
 this 7th day of February, 1962.

Inez M. Underwood
 Notary Public

My commission expires: March 15, 1962