

STATE OF KANSAS
STATE CORPORATION COMMISSION

Give All Information Completely
Make Required Affidavit
Mail or Deliver Report to:
Conservation Division
State Corporation Commission
800 Bitting Building
Wichita, Kansas

WELL PLUGGING RECORD

Pratt County, Sec. 17 Twp. 28S Rge. 13 (W)

Location as "NE/CNW/SW" or footage from lines SE NE SW

Lease Owner Sinclair Oil & Gas Company

Lease Name Frank SMITH Well No. 1

Office Address P. O. Box 521, Tulsa 2, Oklahoma

Character of Well (completed as Oil, Gas or Dry Hole) DRY HOLE

Date well completed October 10, 1954 19

Application for plugging filed October 9, (Verbal) 19 54

Application for plugging approved October 12, 19 54


Plugging commenced October 10, 19 54

Plugging completed October 10, 19 54

Reason for abandonment of well or producing formation DRY HOLE (Oil string not run)

If a producing well is abandoned, date of last production 19

Was permission obtained from the Conservation Division or its agents before plugging was commenced? Yes

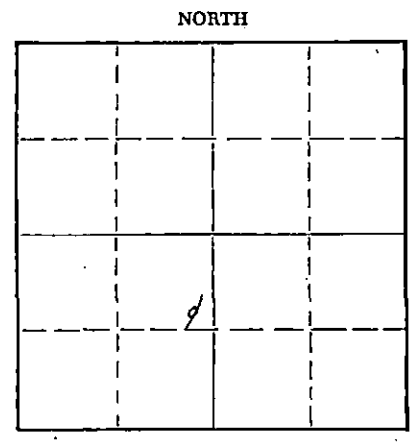

Locate well correctly on above Section Plat

Name of Conservation Agent who supervised plugging of this well Mr. A. Rives, Box 8, Pratt, Kansas

Producing formation Depth to top Bottom Total Depth of Well 4600 Feet

Show depth and thickness of all water, oil and gas formations.

OIL, GAS OR WATER RECORDS

CASING RECORD

FORMATION	CONTENT	FROM	TO	SIZE	PUT IN	PULLED OUT
Shale & Red Beds				10-3/4"	225'	NONE

Describe in detail the manner in which the well was plugged, indicating where the mud fluid was placed and the method or methods used in introducing it into the hole. If cement or other plugs were used, state the character of same and depth placed, from feet to feet for each plug set.

	FROM	TO
Mud	4600	300'
50-Sacks Cement	300	240'
Mud	240	220'
20-Sacks Cement	220	35'
Halliburton Plug	35	31'
15 - Sacks Cement	31'	Zero

Name of Plugging Contractor Graham-Messman-Rinehart Drig. Co. (License No. 20)
Address 1005 East Second Street, Wichita, Kansas

STATE OF KANSAS, COUNTY OF RICE, ss.
I, W. B. Rhees (employee of owner) or (owner/operator) of the above-described well, being first duly sworn on oath, says: That I have knowledge of the facts, statements, and matters herein contained and the log of the above-described well as filed and that the same are true and correct. So help me God.

PLUGGING
FILED SEC 17 T 28 R 13W
BOOK PAGE 20 LINE 9

(Signature) W. B. RHEES
P. O. Box 551, Chase, Kansas (Address)

SUBSCRIBED AND SWORN to before me this 18th day of OCTOBER, 19 54

My commission expires April 24-1956

Notary Public.

Orig: Corporation Commission - Wichita
cc: Mr. A. Rives, State Plugger - Pratt, Kansas
Sinclair Oil & Gas Company - Tulsa (2)
" " " " (Geological Department) Wichita
File

10-19-54

15-151-00417

SINCLAIR OIL & GAS COMPANY

W E L L L O G

FARM: Frank X. Smith
WELL No: 1
Location: SE - NE - SW 17-28S-13W
County: Pratt
State: KANSAS

Location Staked: August 20, 1954
Spudded: Sept. 22, 1954
Elevation: 1921' GLM
" 1923' DFM

DRILLERS LOG

Sand-Clay	132
Shale	733
Anhydrite	758
Shale	776
Lime-Shale	873
Shale	1793
Shale-Lime	1983'
Lime-Shale	2519'
Shale-Lime	2920'
Lime-Shale	3058'
Shale-Lime	3322
Lime-Shale	3513
Lime	3660
Lime-Shale-Sand	3784
Lime-Shale	3875
Lime	4040
K. C. Lime	4245
Cherty Lime	4337
Lime-Chert	4365
Lime	4393
Lime-Chert	4415
Viola chert	4423
Lime	4465
Shale (Simpson)	4474
Coring	4494
Simpson	4511
Coring	4515
Simpson	4575
Arbuckle	4600' (RTD) (Casing not Run)
10-3/4" Surface Csg. Set @ 225' (150-Sacks)	

Geological Tops

Viola	4378 (Dry)
Simpson	4460 (Dry)
Arbuckle	4575' (Dry)

Drilling Completed: ~~10/10/54~~ 10/10/54

Drilling Contractor: Graham-Messman-Rinehart Drlg. Co.
1005 East 2nd Street
Wichita, Kansas

Plugging Contractor: Graham-Messman-Rinehart Drlg. Co. License No. 20
1005 East 2nd Street
Wichita, Kansas

Plugging commenced & completed: October 10, 1954 State Permit File 70-9
District Plugging Supervisor in Charge: Mr. M. A. Rives, Box 8, Pratt, Kansas

Orig: w/ Well Plugging Record to: State Corporation Commission - Wichita
cc " " Mr. M. A. Rives, Box 8, Pratt, Kansas
" " Sinclair Oil & Gas Co. (Prod. Dept) Tulsa, Okla.
" " " (Geol. Dept) Wichita

FILE

