


STATE OF KANSAS
STATE CORPORATION COMMISSION
Give All Information Completely
Make Required Affidavit
Mail or Deliver Report to:
Conservation Division
State Corporation Commission
211 No. Broadway
Wichita, Kansas

WELL PLUGGING RECORD

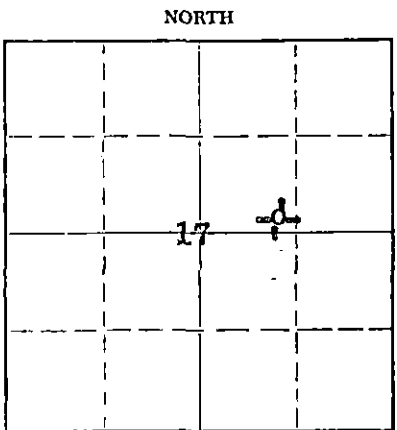

Locate well correctly on above
Section Plat

Pratt County, Sec. 17 Twp. 28S Rge. 13W (xx) (W)
Location as "NE/CNW/SW" or footage from lines SE SW NE
Lease Owner D. R. Lauck Oil Company, Inc.
Lease Name Frank L. Smith Well No. 1
Office Address 301 S. Broadway, Wichita, Kansas
Character of Well (completed as Oil, Gas or Dry Hole) Dry Hole
Date well completed July 20, 19 63
Application for plugging filed July 20, 19 63
Application for plugging approved July 20, 19 63
Plugging commenced July 20, 19 63
Plugging completed July 20, 19 63
Reason for abandonment of well or producing formation Dry Hole

If a producing well is abandoned, date of last production _____ 19 ____
Was permission obtained from the Conservation Division or its agents before plugging was commenced? Yes

Name of Conservation Agent who supervised plugging of this well Archie V. Elving
Producing formation _____ Depth to top _____ Bottom _____ Total Depth of Well 4600 Feet
Show depth and thickness of all water, oil and gas formations.

OIL, GAS OR WATER RECORDS

CASING RECORD

FORMATION	CONTENT	FROM	TO	SIZE	PUT IN	PULLED OUT
		0'	318'	8-5/8"	318'	None

Describe in detail the manner in which the well was plugged, indicating where the mud fluid was placed and the method or methods used in introducing it into the hole. If cement or other plugs were used, state the character of same and depth placed, from _____ feet to _____ feet for each plug set.

4600' - 240' Mud
240' - 236' Plug
236' - 40' Cement, 20 sacks
40' - 6' Cement, 10 sacks & 1/2 sack hulls
(bottom of cellar)

RECEIVED
STATE CORPORATION COMMISSION

AUG 5 1963

CONSERVATION DIVISION
Wichita, Kansas

(If additional description is necessary, use BACK of this sheet)
Name of Plugging Contractor Sun Cementing Co.
Address Great Bend, Kansas

STATE OF KANSAS, COUNTY OF SEDGWICK, ss.
John H. Knightley (employee of owner) or (owner or operator) of the above-described well, being first duly sworn on oath, says: That I have knowledge of the facts, statements, and matters herein contained and the log of the above-described well as filed and that the same are true and correct. (So help me God.)

(Signature) John H. Knightley
301 S. Broadway, Wichita, Kansas
(Address)

SUBSCRIBED AND SWORN TO before me this 1st day of August, 19 63.

My commission expires March 12, 1967
Stella J. Lippie Notary Public.

D. R. Lauck Oil Company, Inc.

Frank L. Smith #1

SE SW NE Sec. 17-28S-13W
Pratt County, KansasCommenced: July 6, 1963
Completed: July 20, 1963Casing Record: 318' 8-5/8" Cemented with 210 sacks Cement,
4 sacks Calcium Chloride.

Elevation: 1913 GL; 1916 DF; 1918 KB.

Drillers LogTops

Clay	60
Sand	75
Shale	125
Sand	175
Shale & Red Bed	240
Shale & Shells	315
Sandy Red Bed	765
Red Bed & Anhydrite Streaks	785
Red Bed & Shale	900
Shale & Shells	1645
Anhydrite	2078
Shale & Lime	2210
Lime & Shale	2645
Shale & Shells	2895
Shale & Lime	3055
Lime & Shale	3120
Broken Lime & Shale	3310
Shale & Lime	3440
Lime	3525
Lime & Shale	3695
Shale & Lime	3815
Lime & Shale	3860
Lime	4210
Lime & Shale	4245
Lime	4308
Conglomerate	4350
Viola	4355
Lime	4382
Lime, Shale & Chert	4420
Chert & Shale	4460
Chert & Sand	4482
Shale, Lime & Chert	4559
Lime	4600

	Sample
Heebner	3666-1748
Toronto	3681-1763
Douglas	3701-1783
Brown Limestone	3848-1930
Lansing	3862-1944
Base Kansas City	4217-2299
Mississippian	4296-2378
Viola	4350-2432
Simpson Shale	4461-2543
Simpson Sand	4467-2549
Arbuckle	4565-2647
Total Depth	4600-2682

DST #1 (M) 2945-3055, open 1 hr.
w/strong decreasing blow.
Recovered 1730' muddy water.
ISIP 1510#/30 min.
FSIP 1045#/15 min.
IFP 470#
FFP 835#

DST #2 (M) 4035-4058, open 1 hr. w/
fair decreasing blow. Recovered
480' of gas, 120' gassy oil
specked watery mud.
ISIP 1410#/30 min.
FSIP 1020#/30 min.
IFP 40#
FFP 140#

DST #3 (M) 4344-4355, open 1 hr. w/
weak blow 5 min. Recovered 10'
of mud.
ISIP 1010#/30 min.
FSIP 440#/30 min.
IFP 50#
FFP 70#

RECEIVED
STATE CORPORATION COMMISSION

AUG 5 1963

CONSERVATION DIVISION
Wichita, Kansas

D&A