

STATE OF KANSAS
STATE CORPORATION COMMISSION

WELL PLUGGING RECORD


Give All Information Completely
Make Required Affidavit
Mail or Deliver Report to
Conservation Division
State Corporation Comm.
245 North Water
Wichita, KS 67202

Pratt County. Sec. 17 Twp. 28 Rge. 13 N/W
Location as "NE/CNW/SW" or footage from lines
1/4 C/NW 1/4 SE 1/4 NW 1/4

Lease Owner petrie Enterprises, Inc.
Lease Name Frank L. Smith Well No. 21

Office Address R. R. # 1 Pratt, Kansas 67124
Character of Well (Completed as Oil, Gas or Dry Hole)
Dry Hole

Date Well completed September 3 1978
Application for plugging filed September 3 1978
Application for plugging approved September 3 1978
Plugging commenced September 3 1978
Plugging completed September 3 1978
Reason for abandonment of well or producing formation
Dry

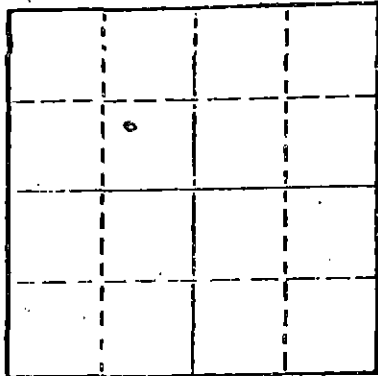

Locate well correctly on above
Section Plat

If a producing well is abandoned, date of last production
19

Was permission obtained from the Conservation Division or
its agents before plugging was commenced? Yes

Name of Conservation Agent who supervised plugging of this well William T. Owens
Producing formation _____ Depth to top _____ Bottom _____ Total Depth of Well _____
Show depth and thickness of all water, oil and gas formations.

OIL, GAS OR WATER RECORDS

CASING RECORD

FORMATION	CONTENT	FROM	TO	SIZE	PUT IN	PULLED OUT

Describe in detail the manner in which the well was plugged, indicating where the mud fluid
was placed and the method or methods used in introducing it into the hold. If cement or other
plugs were used, state the character of same and depth placed, from _____ feet to
_____ feet for each plug set.

Plugged:
With 40 sacks @ 540'
With 50 sacks @ 210'
With 12 sacks @ 40'
Completed @ 7:00 AM
Plugged by Howco

(If additional description is necessary, use BACK of this sheet)

Name of Plugging Contractor Gabbert & Jones 830 Sutton place
Wichita, Kansas

STATE OF _____ COUNTY OF _____ ss.

(employee of owner) or (owner or operator) of the above-described
well, being first duly sworn on oath, says: That I have knowledge of the facts, statements, and matters herein contained and the log of the
above-described well as filed and that the same are true and correct. So help me God.

(Signature) [Signature]
1717 Pratt, Kansas
(Address)

SUBSCRIBED AND SWORN TO before me this 25th day of September 1978

My commission expires _____



Notary Public.

RECEIVED
STATE CORPORATION COMMISSION

SEP 26 1978

CONSERVATION DIVISION
Wichita, Kansas

GABBERT-JONES, INC.
 WICHITA, KANSAS
 DRILLERS' WELL LOG

RECEIVED
 STATE CORPORATION COMMISSION

SEP 26 1978

CONSERVATION DIVISION
 Wichita, Kansas

Frank L. Smith #2
 NW/4 Sec 17-28S-13W
 Pratt County Kansas

Commenced: 8-28-78

Completed: 9-3-78

OPERATOR: Petrie Exploration Co.

Depth		Formation	Remarks
From	to		
0	213	Sand-Redbed	Ran 6 jts of 43/ 12 1/2" csg
213	475	Clay-Redbed	set @ 204' Cemented w/
475	1691	Shale-Shells	275 sks 60/40 Posmix
1691	1915	Shale	2% Gel - 3% CC
1915	2065	Lime	PD @ 9:30 p.m.
2065	2760	Lime-Shale	8-28-78
2760	3150	Shale-Lime	
	3150 - TD		DRY & ABANDONED

STATE OF KANSAS)
) SS
 COUNTY OF SEDGWICK)

I, the undersigned, being duly sworn on oath, state that the above Drillers' Well Log is true and correct to the best of my knowledge and belief and according to the records of this office.

GABBERT-JONES, INC.

James S. Sutton II
 JAMES S. SUTTON II

Subscribed and sworn to before me this 11th day of September, 1978.

Elizabeth J. Edwards
 ELIZABETH J. EDWARDS-NOTARY PUBLIC

My Commission expires February 6, 1979.

