


WELL PLUGGING RECORD

Give All Information Completely
Make Required Affidavit
Mail or Deliver Report to:
Conservation Division
State Corporation Commission
800 Bittling Building
Wichita, Kansas

Harper County, Sec. 35 Typ. 31S Rge. 9 (E) (W)
G SW SE

Location as "NE/CNW $\frac{1}{4}$ SW $\frac{1}{4}$ " or footage from lines
Lease Owner The Carter Oil Company
Lease Name Elaine Levand Well No. 1
Office Address Box 786, Great Bend, Kansas
Character of Well (completed as Oil, Gas or Dry Hole) oil well
Date well completed November 28 1954
Application for plugging filed June 25 1956
Application for plugging approved June 26 1956
Plugging commenced July 8 1956
Plugging completed July 11 1956
Reason for abandonment of well or producing formation uneconomical to operate

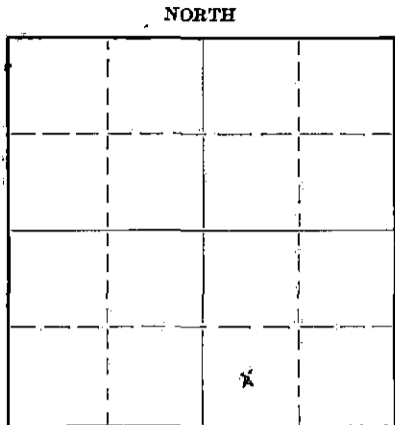

Locate well correctly on above Section Plat

If a producing well is abandoned, date of last production November 4 1955
Was permission obtained from the Conservation Division or its agents before plugging was commenced? yes

Name of Conservation Agent who supervised plugging of this well Mr. M. A. Rives
Producing formation Mississippi Lime Depth to top 4398 Bottom 4391 Total Depth of Well 4398 Feet
Show depth and thickness of all water, oil and gas formations.

OIL, GAS OR WATER RECORDS

CASING RECORD

Formation	Content	From	To	Size	Put In	Pulled Out
Top Mississippi	oil	4397 (-2826)		8-5/8 5-1/2	223' 4340'	none 3607'

Describe in detail the manner in which the well was plugged, indicating where the mud fluid was placed and the method or methods used in introducing it into the hole. If cement or other plugs were used, state the character of same and depth placed, from _____ feet to _____ feet for each plug set.

Heavy rotary mud from 4398' to 235'
Rock bridge from 235' to 225'
20 sax cement from 225' to 155'
Heavy mud from 155' to 40'
Rock bridge from 40' to 35'
8-5/8" Cement Plug from 35' to top of 8-5/8" casing

Note: 8-5/8" casing cut off 4' below ground level.

(If additional description is necessary, use BACK of this sheet)

Correspondence regarding this well should be addressed to The Carter Oil Company
Address Box 786
Great Bend, Kansas

STATE OF Kansas, COUNTY OF Barton, ss.
Hugh H. Goerner (employee of owner) of the above-described well,
being first duly sworn on oath, says: That I have knowledge of the facts, statements, and matters herein contained and the log of the above-described well as filed and that the same are true and correct. So help me God.

(Signature) *Hugh H. Goerner*
Box 786, Great Bend, Kansas
(Address)

SUBSCRIBED AND SWORN to before me this 13th day of July, 1956

My commission expires August 19, 1957

PLUGGING
FILE SEC 35 T. 31 R. 90
BOOK PAGE 74 LINE 17

7-16-56

Notary Public.

WELL LOG BUREAU—KANSAS GEOLOGICAL SOCIETY

508 East Murdock,

Wichita, Kansas

15-077-00049-0000

Company- THE CARTER OIL CO.
Farm- Elaine Levand No.1

SEC. 35 T. 31 R. 9W
CSW SE/4

Total Depth. 4406'

Comm. 10-30-54

Comp. 11-18-54


Shot or Treated.

Contractor.

Issued. 3-26-55

County Harper

KANSAS

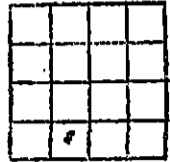

Elevation. 1571' DF

Production. 17 BO

CASING:

8 5/8" 228' cem w/150 sx
5 1/2" 4392' cem w/150 sx

Figures indicate Bottom of Formations.

surface soil & sand	230
red bed & shale	880
shale & shells	1363
shale & lime	1660
lime & shale	1990
shale	2000
shale & shells	2095
shale & lime	3200
lime & shale	3320
lime & shale	3574
lime	3600
lime & shale	3757
lime	3840
shale & lime	3913
lime	3950
lime & shale	4024
lime	4130
shale & lime	4184
lime	4289
shale & lime	4360
shale	4406
Total Depth	

Tops:

Lansing (Scout)	3661
Kansas City "	3943
Base Kansas City (Scout)	4184
Mississippi "	4392
Misner	4397

FILED
COMMISSION

JUN 27 1955

WELL LOGS DIVISION
WICHITA, KANSAS

PLUGGING
FILE SEC. 35 T. 31 R. 9W
BOOK PAGE 74 LINE 17