


WELL PLUGGING RECORD

Give All Information Completely
Make Required Affidavit
Mail or Deliver Report to:
Conservation Division
State Corporation Commission
211 No. Broadway
Wichita, Kansas

Harper County. Sec. 35 Twp. 31 Rge. 9 (W)
Location as "NE/CNW/SW" or footage from lines NW NW NE
Lease Owner Hilton Drilling Company, Inc.
Lease Name Newberry Well No. 1
Office Address P.O. Box 108, Great Bend, Kansas
Character of Well (completed as Oil, Gas or Dry Hole) oil
Date well completed December 26, 19 55
Application for plugging filed November 12, 19 57
Application for plugging approved November 13, 19 57
Plugging commenced December 9, 19 57
Plugging completed December 15, 19 57
Reason for abandonment of well or producing formation
no production
If a producing well is abandoned, date of last production December 15, 19 56
Was permission obtained from the Conservation Division or its agents before plugging was commenced? yes

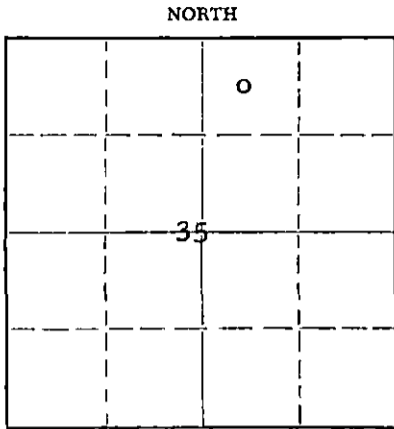

Locate well correctly on above Section Plat

Name of Conservation Agent who supervised plugging of this well M. A. Rives
Producing formation Miss. Chert. Depth to top 4417 Bottom 4421 Total Depth of Well 4428 Feet
Show depth and thickness of all water, oil and gas formations.

OIL, GAS OR WATER RECORDS

CASING RECORD

FORMATION	CONTENT	FROM	TO	SIZE	PUT IN	PULLED OUT
				8-5/8"	165'	none
				5-1/2"	4453'	3497'

Describe in detail the manner in which the well was plugged, indicating where the mud fluid was placed and the method or methods used in introducing it into the hole. If cement or other plugs were used, state the character of same and depth placed, from _____ feet to _____ feet for each plug set.

Plugged back with sand to 4400' and dumped 5 sacks cement. Filled to 200', set 5' rock bridge cemented with 24 sacks cement, mud to 35', set 5' rock bridge cemented with 10 sacks cement from 30' to base of cellar.

RECEIVED
STATE CORPORATION COMMISSION

DEC 31 1957

CONSERVATION DIVISION
Wichita, Kansas

(If additional description is necessary, use BACK of this sheet)
Name of Plugging Contractor Ace Pipe Pulling Company
Address Great Bend, Kansas

STATE OF KANSAS, COUNTY OF BARTON, ss.
Jack L. Craft, Ass't. Secretary (employee of owner) or (owner or operator) of the above-described well, being first duly sworn on oath, says: That I have knowledge of the facts, statements, and matters herein contained and the log of the above-described well as filed and that the same are true and correct. So help me God.

(Signature) Jack L. Craft
Great Bend, Kansas (Address)

SUBSCRIBED AND SWORN TO before me this 30th day of December, 19 57.

Mildred Hobbie

Notary Public.

My commission expires _____

WILDRED HOBBIIE
MY COMMISSION EXPIRES MARCH 6, 1958

PLUGGING
FILE SEC 35 T. 31 R. 9 W
BOOK PAGE 60 LINE 73

S. A. BERWICK DRILLING COMPANY

1105 Williams

Great Bend, Kansas

15-077-10116-0000

Newberry #1

NW NW NE Sec. 35-31-9
Harper County, Kansas

Total Depth: 4428'
Commenced R. D. : 11-29-55
Completed R. D. : 12-14-55

Elevation:
Initial Prod.:
Contractor: S. A. Berwick
Drilling Co.

Strata	Depth
Sand	0 - 40'
Shale and Shells	40 - 115'
Red Rock and Shale	115 - 165'
Shale and Shells	165 - 1365'
Shale and Lime	1365 - 2510'
Shale	2510 - 2690'
Shale and Lime	2690 - 2885'
Lime	2885 - 2930'
Lime and Shale	2930 - 3725'
Lime	3725 - 3916'
Lime and Shale	3916 - 3995'
Lime	3995 - 4284'
Lime and Shale	4284 - 4403'
Lime	4403 - 4418'
Miss. Chat	4418 - 4428'

I hereby certify the above a true and correct log of said well as reflected by the daily drilling report.

S. A. BERWICK DRILLING COMPANY

By S. A. Berwick
S. A. Berwick, Owner

Signed and sworn to in my presence this 30 day of December, 1955 by S. A. Berwick, owner of the S. A. Berwick Drilling Company.

John W. Ross
Notary Public

My Commission Expires:

4-11-59

PLUGGING
FILE SEC: 35T.31 R. 9W
BOOK PAGE 60 LINE 43