


WELL PLUGGING RECORD

Give All Information Completely
Make Required Affidavit
Mail or Deliver Report to:
Conservation Division
State Corporation Commission
800 Bitting Building
Wichita, Kansas

Harper County. Sec. 36 Twp. 31S Rge. (E) 9 (W)

Location as "NE/CNW/SW" or footage from lines. C SW NW
Lease Owner The British-American Oil Producing Co.
Lease Name Rall Well No. 1
Office Address P. O. Box 3187, Oklahoma City, Oklahoma
Character of Well (completed as Oil, Gas or Dry Hole) Dry Hole
Date well completed December 29 19 54
Application for plugging filed December 29 19 54
Application for plugging approved December 29 19 54
Plugging commenced December 29 19 54
Plugging completed December 30 19 54
Reason for abandonment of well or producing formation Dry Hole

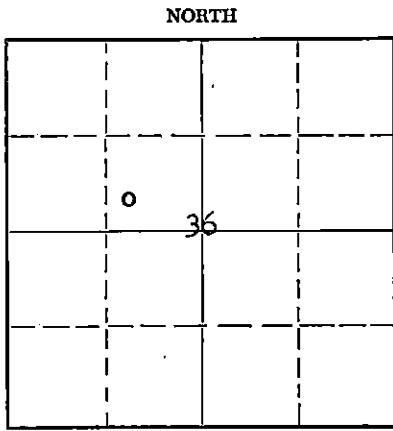

Locate well correctly on above Section Plat

If a producing well is abandoned, date of last production 19
Was permission obtained from the Conservation Division or its agents before plugging was commenced? Yes

Name of Conservation Agent who supervised plugging of this well Ruel Durkee
Producing formation Depth to top Bottom Total Depth of Well 4445 Feet
Show depth and thickness of all water, oil and gas formations.

OIL, GAS OR WATER RECORDS

CASING RECORD

FORMATION	CONTENT	FROM	TO	SIZE	PUT IN	PULLED OUT
See Gamma Ray-Neutron Log attached.				10-3/4"	260.20'	None

Describe in detail the manner in which the well was plugged, indicating where the mud fluid was placed and the method or methods used in introducing it into the hole. If cement or other plugs were used, state the character of same and depth placed, from feet to feet for each plug set.

Ran drill pipe to total depth, gunned pits and circulated hole. Pulled and laid down 100 jts. of drill pipe, gunned pits and circulated hole. Completed laying down drill pipe. Pushed bottom Howco cement plug to 250'. Picked drill pipe up 10' and spotted 40 sacks of cement which filled to 174' in 10-3/4" surface casing. Set top plug at 26' KB and held with Howco line. Spotted 9 sax cement which filled to surface.

REL
STATE CORPORATION COMMISSION
JAN 7 1956
01-04-55
CONSERVATION DIVISION
WICHITA, KANSAS

(If additional description is necessary, use BACK of this sheet)
Name of Plugging Contractor Big X Drilling Company
Address First National Building, Oklahoma City, Oklahoma

STATE OF Oklahoma, COUNTY OF Oklahoma, ss.
Fred Norris (employee of owner) or (owner/operator) of the above-described well, being first duly sworn on oath, says: That I have knowledge of the facts, statements, and matters herein contained and the log of the above-described well as filed and that the same are true and correct. So help me God.

(Signature) Fred Norris
P. O. Box 3187, Oklahoma City, Oklahoma
(Address)

SUBSCRIBED AND SWORN TO before me this 31st day of December 1954

O. O. Floyd
Notary Public.

My commission expires 10-10-56

PLUGGING
FILE SEC 36 T 31 R 9 W
BOOK PAGE 88 LINE 26